

Architectural Documents
of
Mani Bhavan
[Mumbai, Maharashtra, India]

under
Gandhi Heritage Sites Mission (GHSM)
Ministry of Culture, Government of India.

by
Sabarmati Ashram Preservation and Memorial Trust
Ahmedabad, Gujarat.

Project:

Mani Bhavan

19, Laburnum Rd, near Police Station,
Babulnath, Gamdevi
Mumbai, Maharashtra - 400007 India.




Client:

Sabarmati Ashram Preservation
& Memorial Trust

Gandhi Ashram, Gandhi Smarak
Sangrahalaya
Ahmedabad, Gujarat, India - 380 027.


Sheet List		
Sheet Number	Sheet Name	Status
A-00-100	Cover Sheet	-
A-00-101	Site Plan	As-Built Drawings
A-MB-102	Main Building - Ground Floor Plan	As-Built Drawings
A-MB-103	Main Building - First Floor Plan	As-Built Drawings
A-MB-104	Main Building - Second Floor Plan	As-Built Drawings
A-MB-105	Main Building - Terrace Plan	As-Built Drawings
A-MB-201	Main Building - North Elevation	As-Built Drawings
A-MB-202	Main Building - South Elevation	As-Built Drawings
A-MB-203	Main Building - East Elevation	As-Built Drawings
A-MB-204	Main Building - West Elevation	As-Built Drawings
A-MB-301	Main Building - Section A-A	As-Built Drawings
A-MB-302	Main Building - Section B-B	As-Built Drawings
A-OB-102	Old Building - Ground Floor Plan	As-Built Drawings
A-OB-103	Old Building - First Floor Plan	As-Built Drawings
A-OB-104	Old Building - Second Floor Plan	As-Built Drawings
A-OB-105	Old Building - Roof Plan	As-Built Drawings
A-OB-201	Old Building - North Elevation	As-Built Drawings
A-OB-202	Old Building - South Elevation	As-Built Drawings
A-OB-203	Old Building - East Elevation	As-Built Drawings
A-OB-204	Old Building - West Elevation	As-Built Drawings
A-OB-301	Old Building - Section A-A	As-Built Drawings
A-OB-302	Old Building - Section B-B	As-Built Drawings
A-ZZ-401	3D View 1	As-Built Drawings
A-ZZ-402	3D View 2	As-Built Drawings

0	First Issue	03 Oct 2019
Rev.No	Purpose of Issue	Date
R	E	V
I	S	I
O	N	
TITLE:-		
Cover Sheet		
PROJECT:- Gandhi Heritage Sites Mission, Ministry of Culture, Govt. of India		
SITE:- Mani Bhavan 19, Laburnum Rd, near Police Station, Babulnath, Gamdevi, Mumbai, Maharastra - 400007 INDIA		
SCALE:-		DRG.No
DATE:- 03-10-2019		REV.
Size:- A3		0
Executed By:		
Sabarmati Ashram Preservation and Memorial Trust, Ahmedabad 380027, Gujarat - INDIA		
Technical Implementation Agency:		
SHAYONA MANAGEMENT SERVICES PVT. LTD.		
4th Floor, Om Shayona Arcade, Nr.Silver Oak College of Engg.& Tech Gota,Ahmedabad - 382181 Gujarat, INDIA. Phone : +91 9925204263 Email : info@shayonamanagement.com Web : www.shayonamanagement.com		

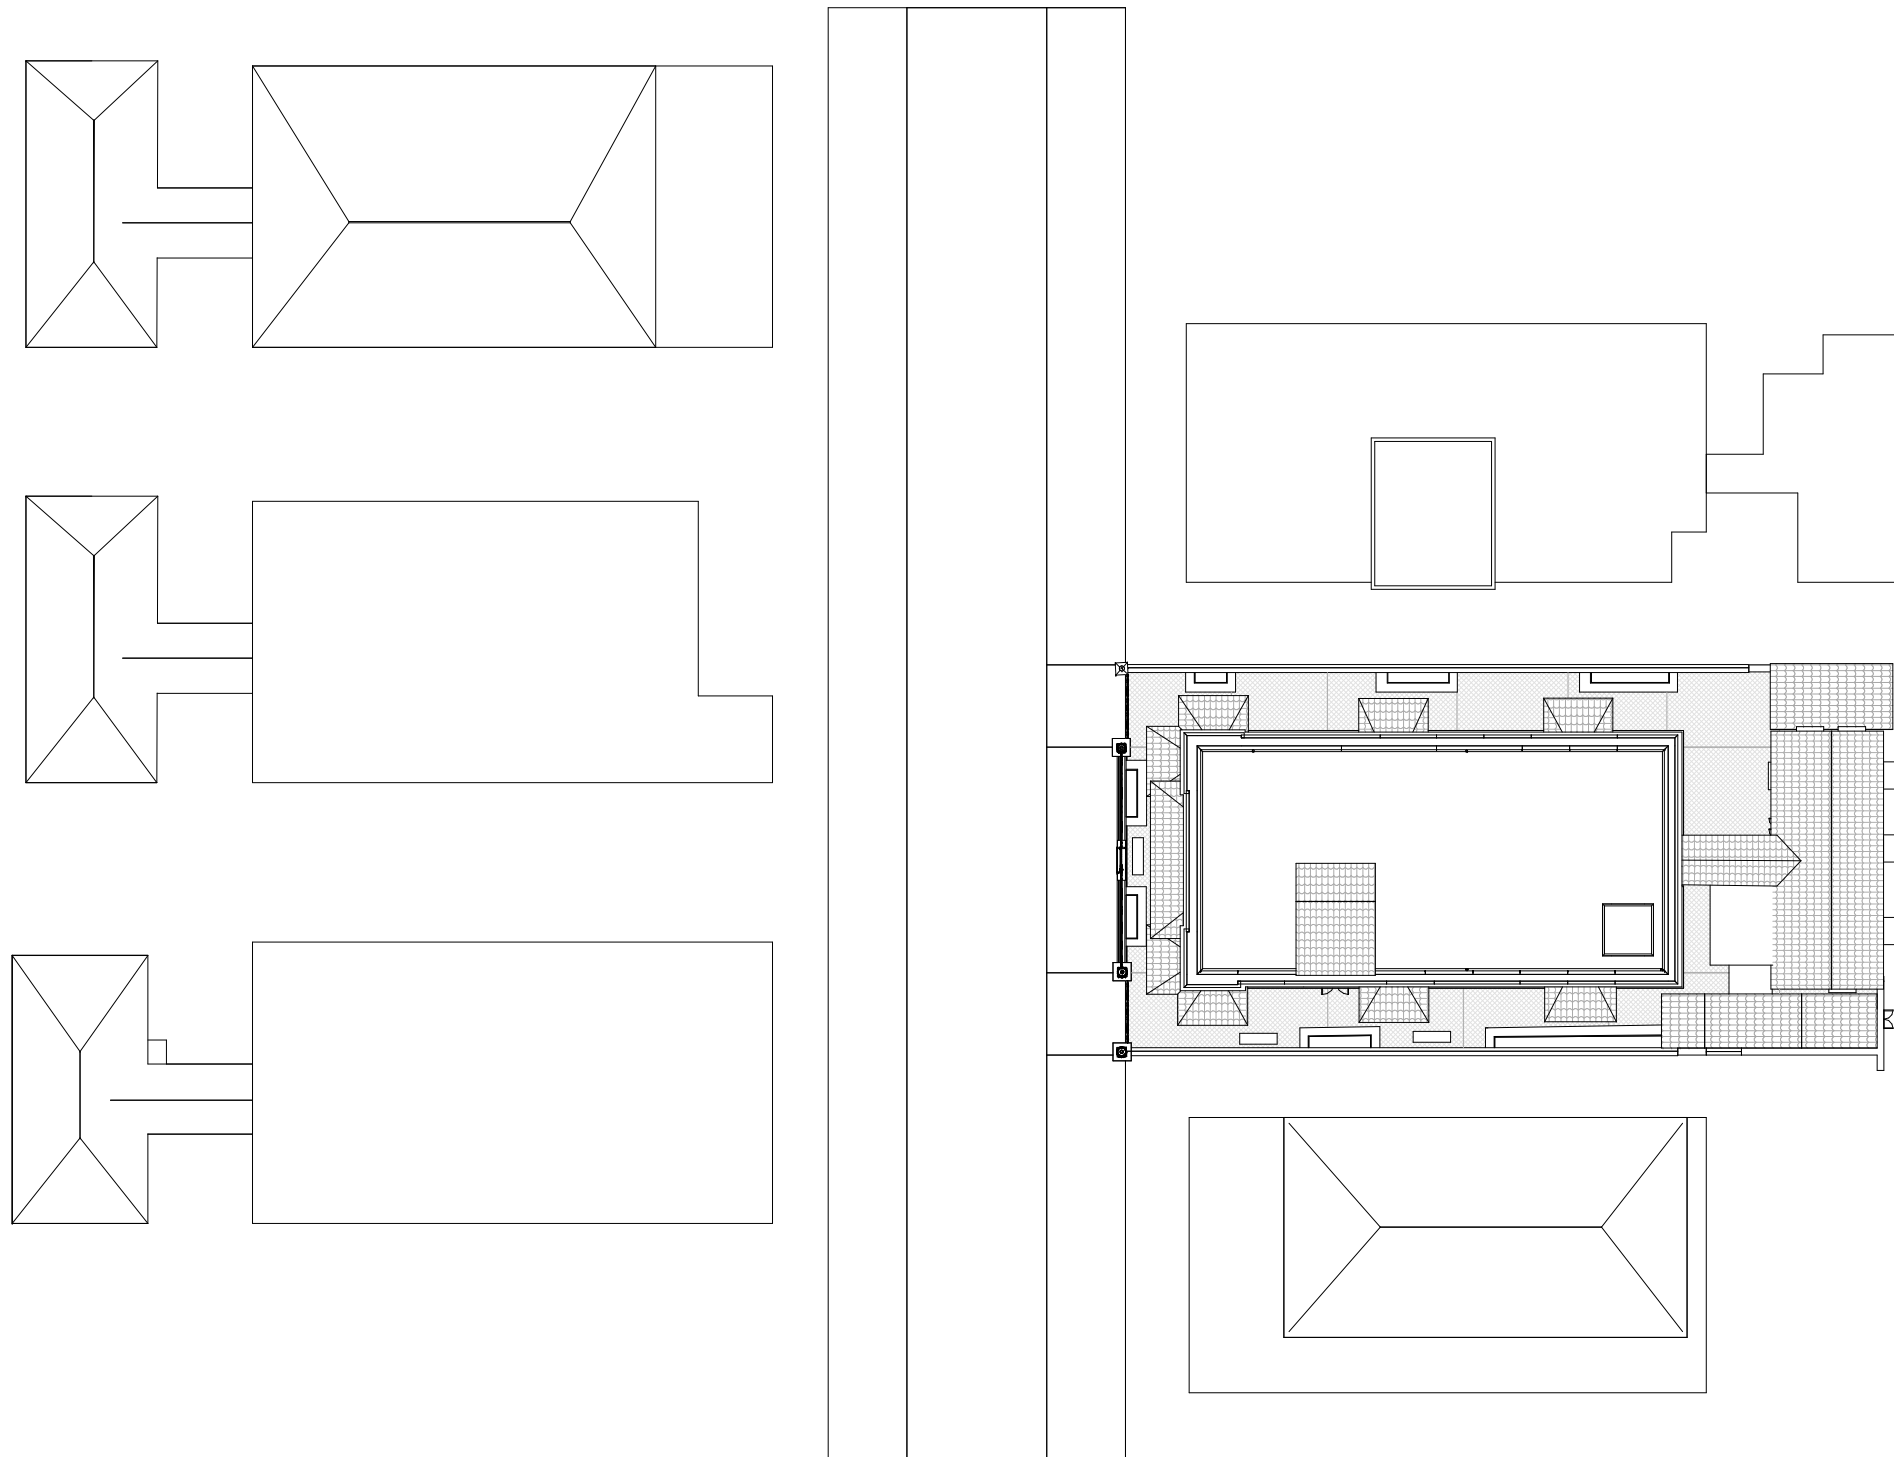


1 Site Plan
1 : 300

0	First Issue	03 Oct 2019
Rev.No	Purpose of Issue	Date
R	E	V
I	S	I
O	N	
TITLE:- Site Plan		
PROJECT:- Gandhi Heritage Sites Mission, Ministry of Culture, Govt. of India		
SITE:- Mani Bhavan 19, Laburnum Rd, near Police Station, Babulnath, Gamdevi. Mumbai, Maharastra - 400007 INDIA		
SCALE:- 1 : 300	DRG.No	REV.
DATE:- 03-10-2019	A-00-101	0
Size:- A3		
Executed By: Sabarmati Ashram Preservation and Memorial Trust, Ahmedabad 380027, Gujarat - INDIA		
Technical Implementation Agency: SHAYONA MANAGEMENT SERVICES PVT. LTD. 4th Floor, Om Shayona Arcade, Nr.Silver Oak College of Engg.&Tech Gota,Ahmedabad - 382181 Gujarat, INDIA. Phone : +91 9925204263 Email : info@shayonamanagement.com Web : www.shayonamanagement.com		

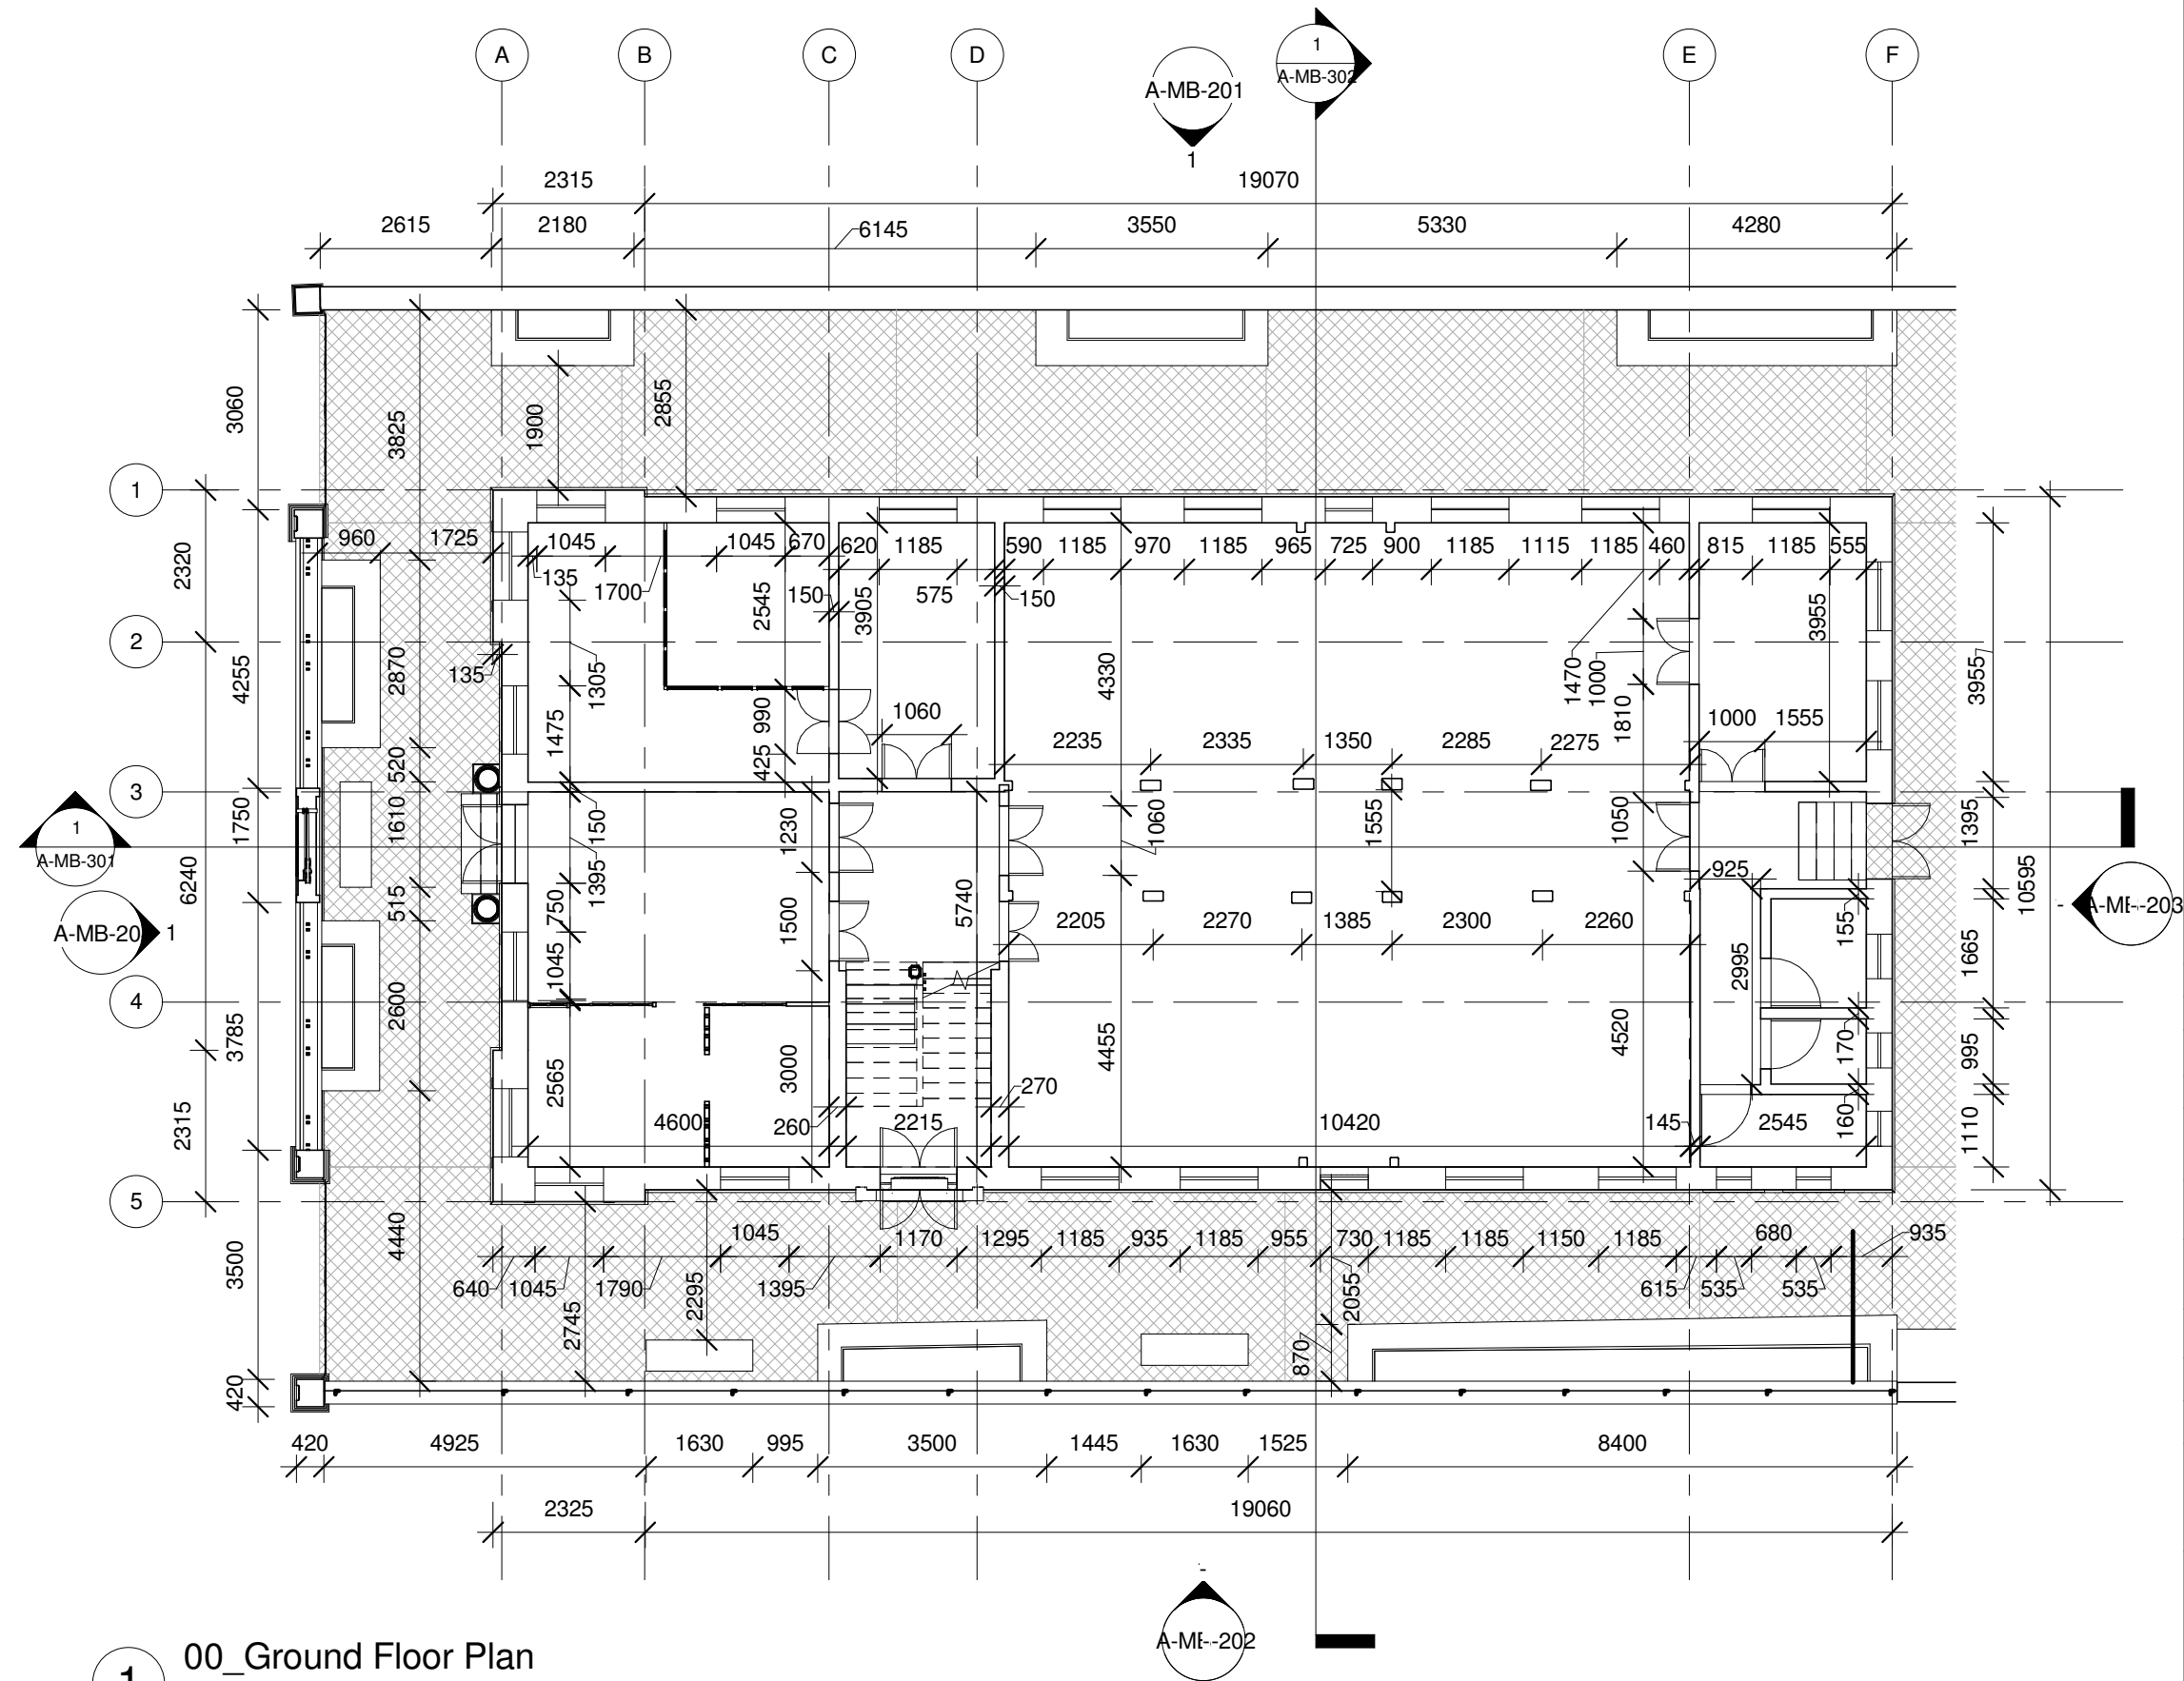


1 00_Ground Floor Plan
1 : 100

0	First Issue	03 Oct 2019	
Rev.No	Purpose of Issue	Date	
R E V I S I O N			
TITLE:- Main Building - Ground Floor Plan			
PROJECT:- Gandhi Heritage Sites Mission, Ministry of Culture, Govt. of India			
SITE:- Mani Bhavan 19, Laburnum Rd, near Police Station, Babulnath, Gamdevi. Mumbai, Maharastra - 400007 INDIA			
SCALE:- 1 : 100		DRG.No	REV.
DATE:- 03-10-2019		A-MB-102	0
Size:- A3			
Executed By: Sabarmati Ashram Preservation and Memorial Trust, Ahmedabad 380027, Gujarat - INDIA			
Technical Implementation Agency: SHAYONA MANAGEMENT SERVICES PVT. LTD. 4th Floor, Om Shayona Arcade, Nr.Silver Oak College of Engg.&Tech Gota,Ahmedabad - 382181 Gujarat, INDIA. Phone : +91 9925204263 Email : info@shayonamangement.com Web : www.shayonamangement.com			

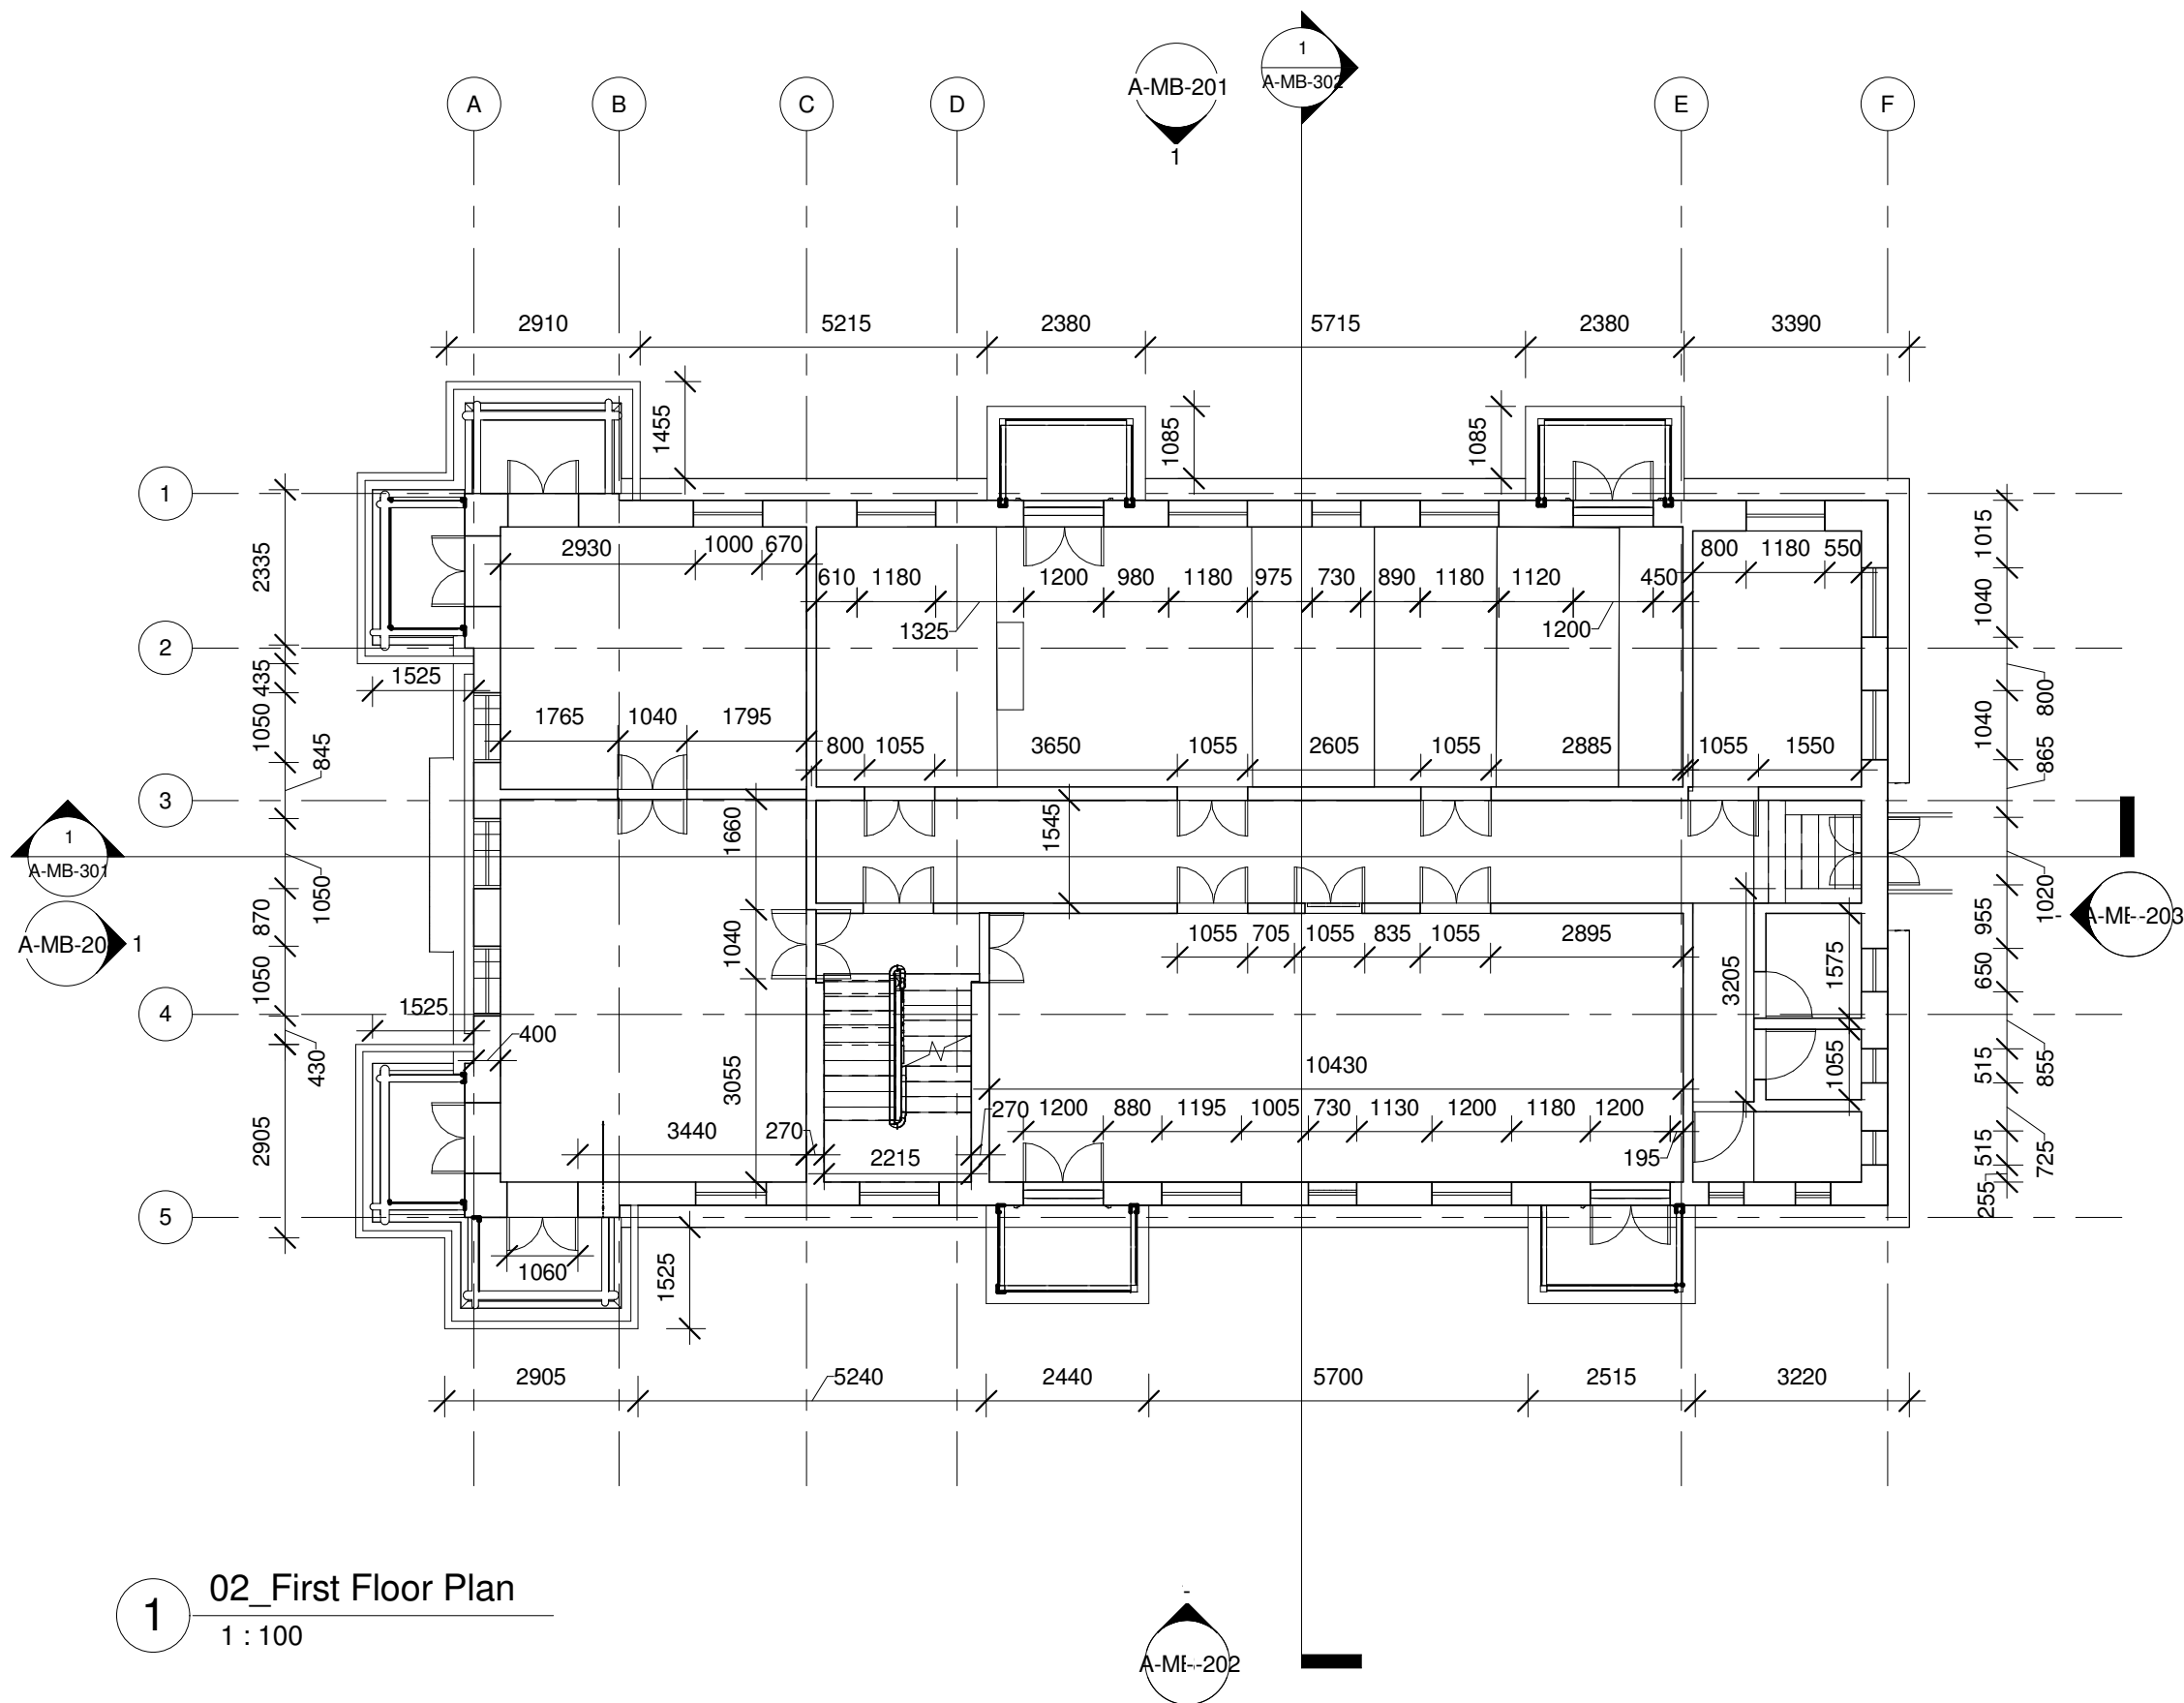


0	First Issue	03 Oct 2019
Rev.No	Purpose of Issue	Date
R E V I S I O N		
TITLE:- Main Building - First Floor Plan		
PROJECT:- Gandhi Heritage Sites Mission, Ministry of Culture, Govt. of India		
SITE:- Mani Bhavan 19, Laburnum Rd, near Police Station, Babulnath, Gamdevi. Mumbai, Maharastra - 400007 INDIA		
SCALE:- 1 : 100	DRG.No	REV.
DATE:- 03-10-2019	A-MB-103	0
Size:- A3		
Executed By: Sabarmati Ashram Preservation and Memorial Trust, Ahmedabad 380027, Gujarat - INDIA		
Technical Implementation Agency: SHAYONA MANAGEMENT SERVICES PVT. LTD. 4th Floor, Om Shayona Arcade, Nr.Silver Oak College of Engg.&Tech Gota,Ahmedabad - 382181 Gujarat, INDIA. Phone : +91 9925204263 Email : info@shayonamanagement.com Web : www.shayonamanagement.com		

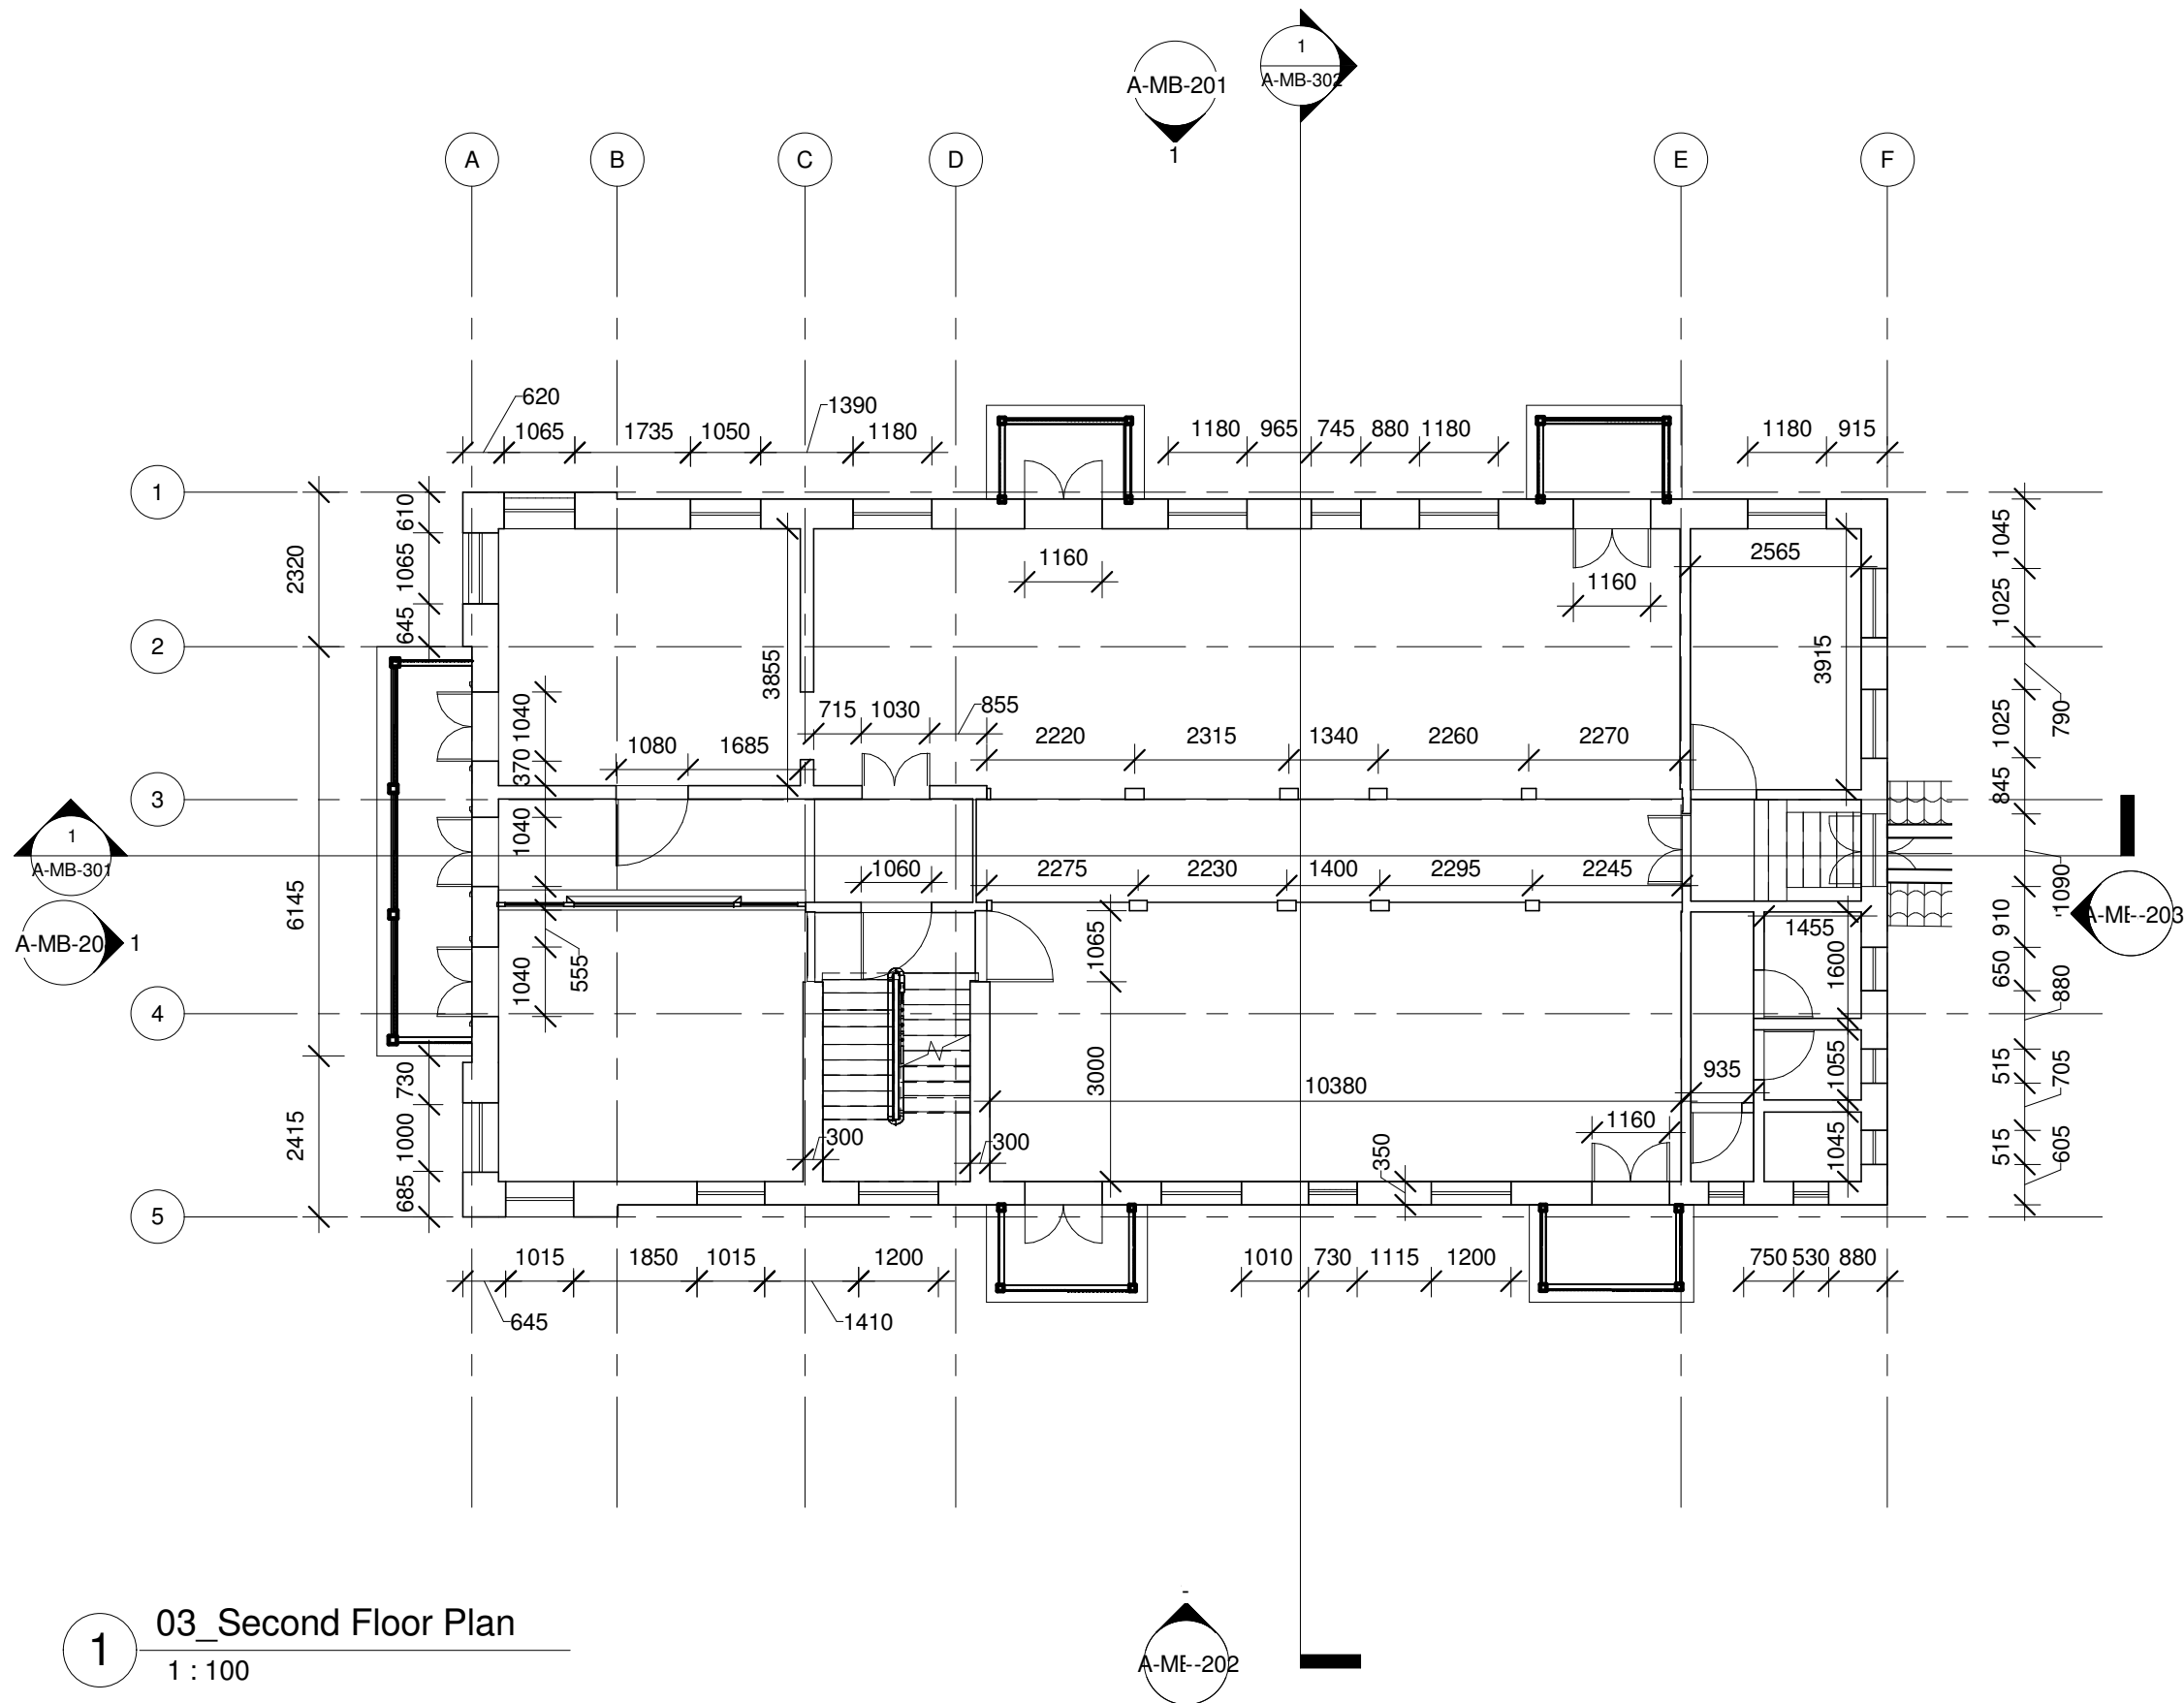


1 03_Second Floor Plan
1 : 100


0	First Issue	03 Oct 2019
Rev.No	Purpose of Issue	Date
R	E	V
I	S	I
O	N	
TITLE:- Main Building - Second Floor Plan		
PROJECT:- Gandhi Heritage Sites Mission, Ministry of Culture, Govt. of India		
SITE:- Mani Bhavan 19, Laburnum Rd, near Police Station, Babulnath, Gamdevi. Mumbai, Maharastra - 400007 INDIA		
SCALE:- 1 : 100		DRG.No
DATE:- 03-10-2019		REV.
Size:- A3		0
A-MB-104		
Executed By: Sabarmati Ashram Preservation and Memorial Trust, Ahmedabad 380027, Gujarat - INDIA		
Technical Implementation Agency: SHAYONA MANAGEMENT SERVICES PVT. LTD. 4th Floor, Om Shayona Arcade, Nr.Silver Oak College of Engg.&Tech Gota,Ahmedabad - 382181 Gujarat, INDIA. Phone : +91 9925204263 Email : info@shayonamanagement.com Web : www.shayonamanagement.com		

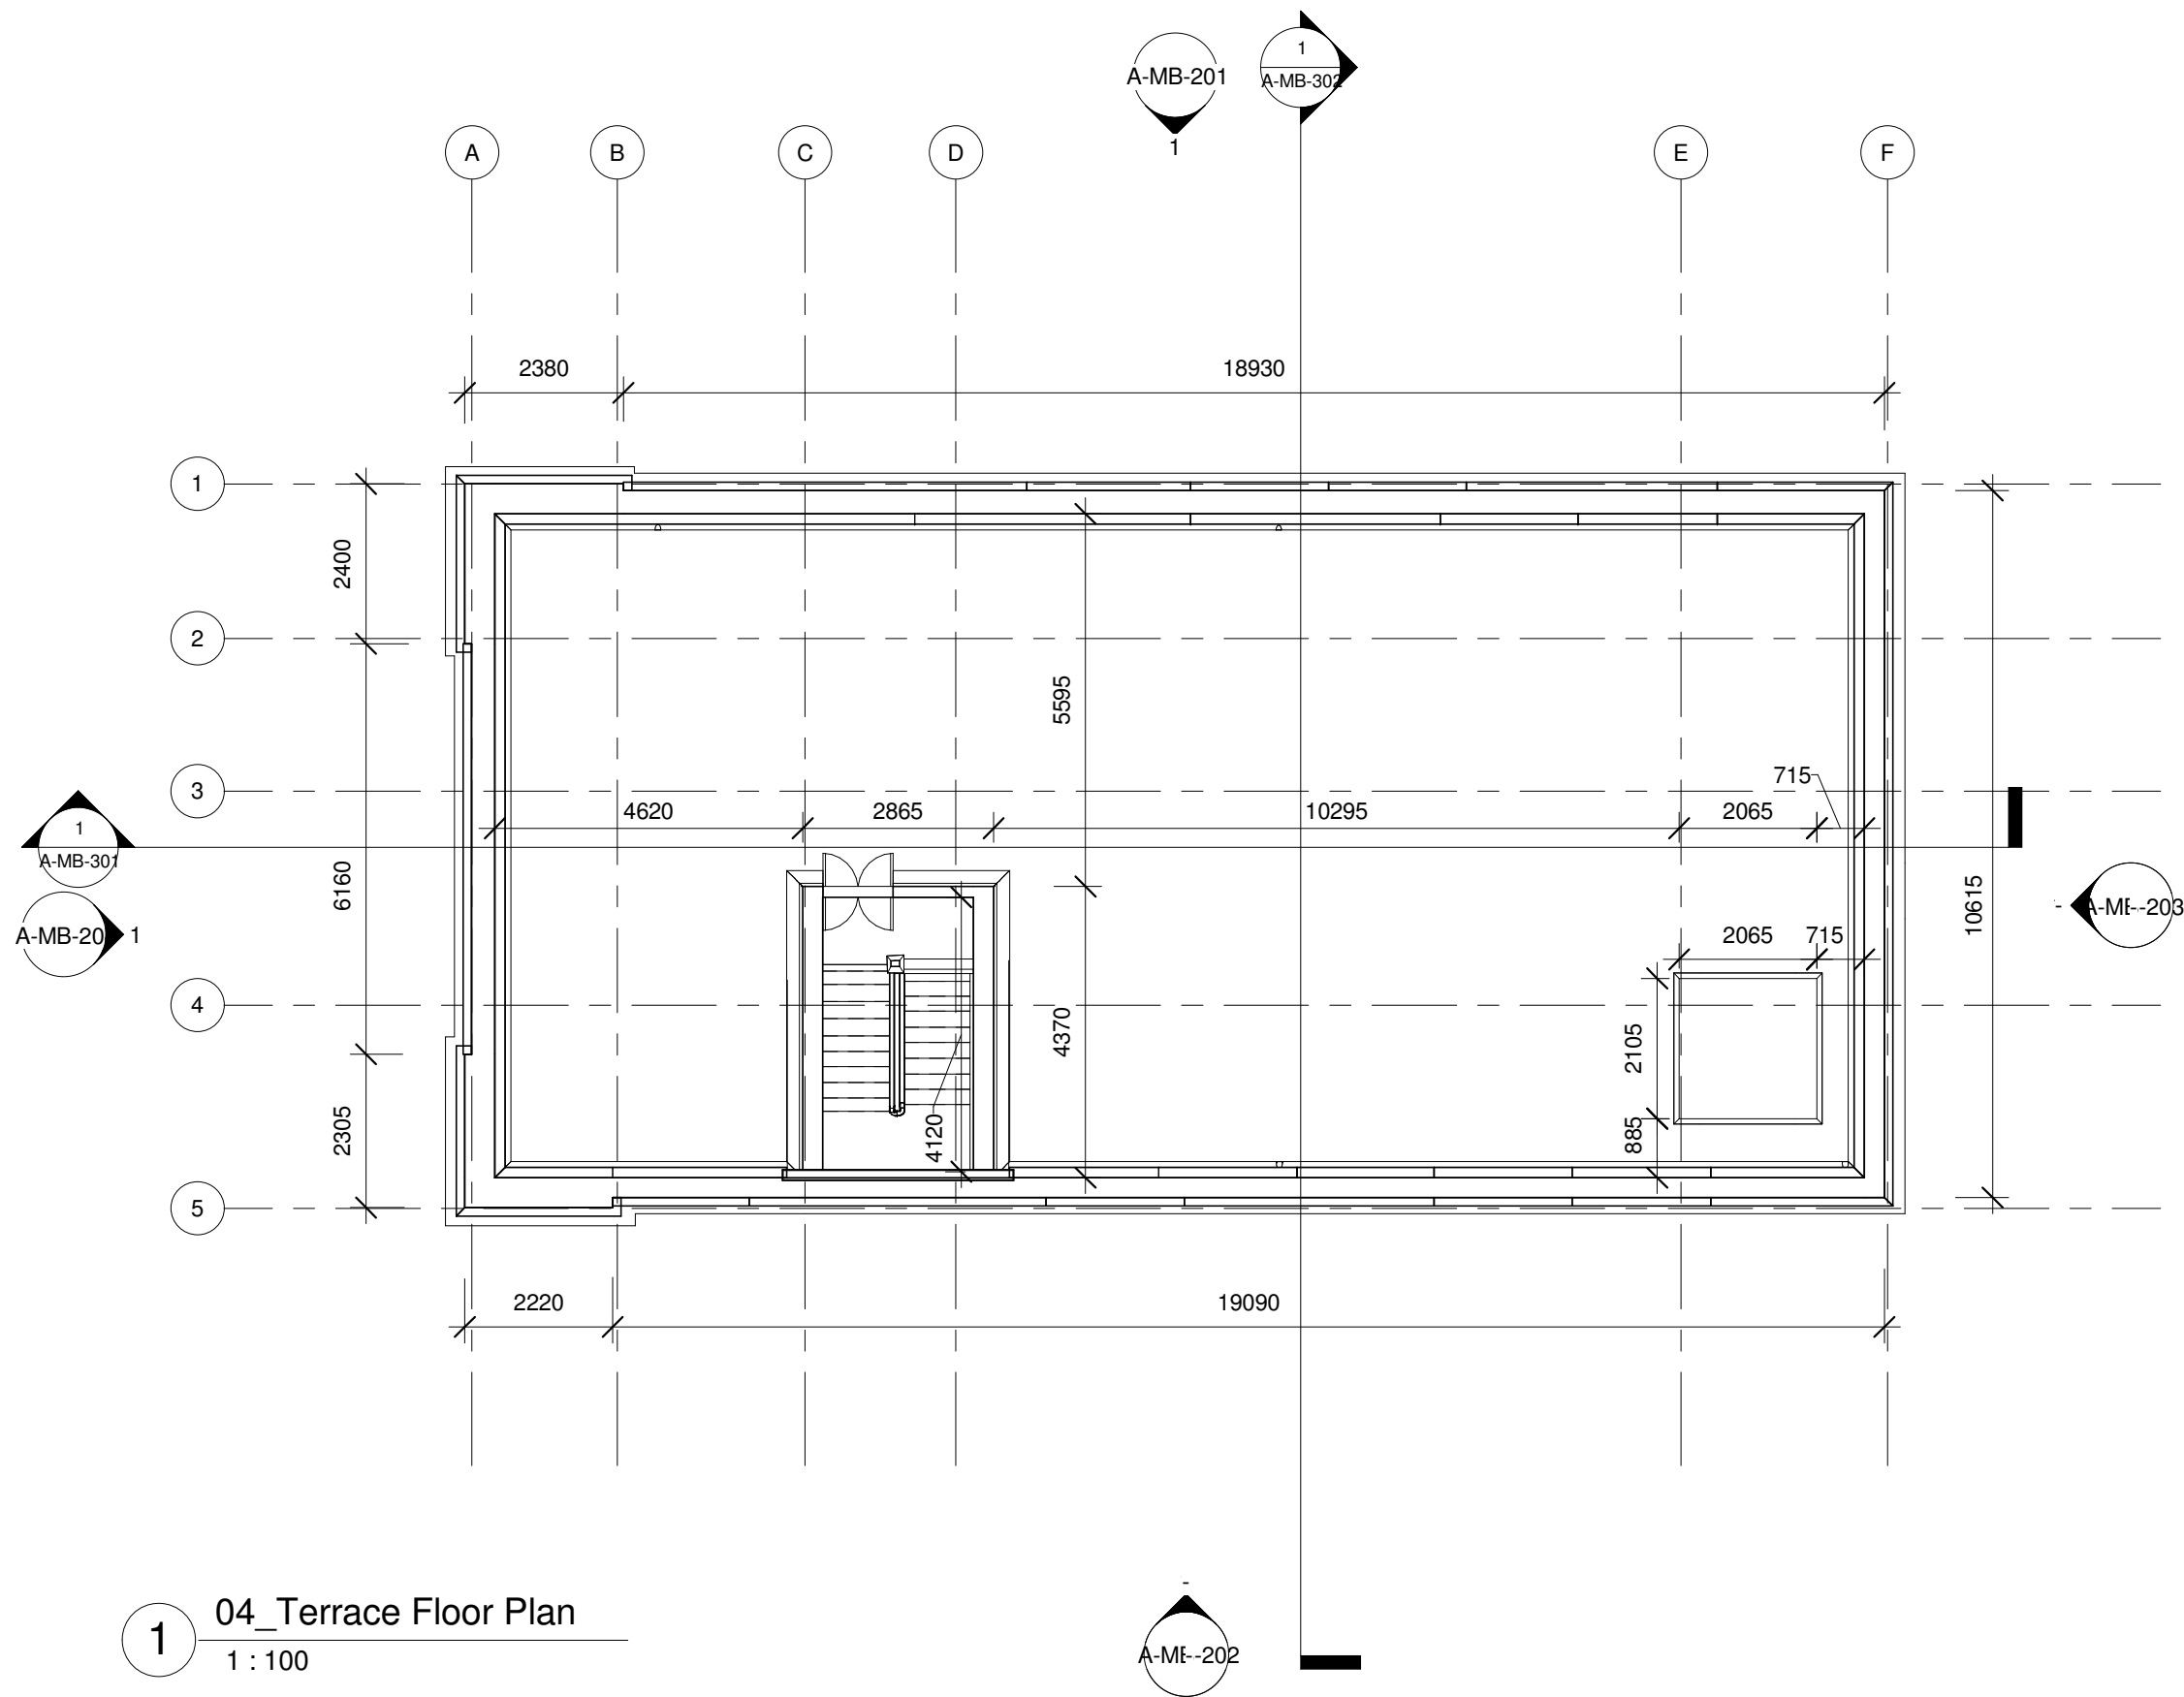

0	First Issue	03 Oct 2019
Rev.No	Purpose of Issue	Date
R	E	V
I	S	I
O	N	
TITLE:- Main Building - Terrace Plan		
PROJECT:- Gandhi Heritage Sites Mission, Ministry of Culture, Govt. of India		
SITE:- Mani Bhavan 19, Laburnum Rd, near Police Station, Babulnath, Gamdevi. Mumbai, Maharastra - 400007 INDIA		
SCALE:- 1 : 100		DRG.No
DATE:- 03-10-2019		REV.
Size:- A3	A-MB-105	0
Executed By: Sabarmati Ashram Preservation and Memorial Trust, Ahmedabad 380027, Gujarat - INDIA		
Technical Implementation Agency: SHAYONA MANAGEMENT SERVICES PVT. LTD. 4th Floor, Om Shayona Arcade, Nr.Silver Oak College of Engg.&Tech Gota,Ahmedabad - 382181 Gujarat, INDIA. Phone : +91 9925204263 Email : info@shayonamanagement.com Web : www.shayonamanagement.com		

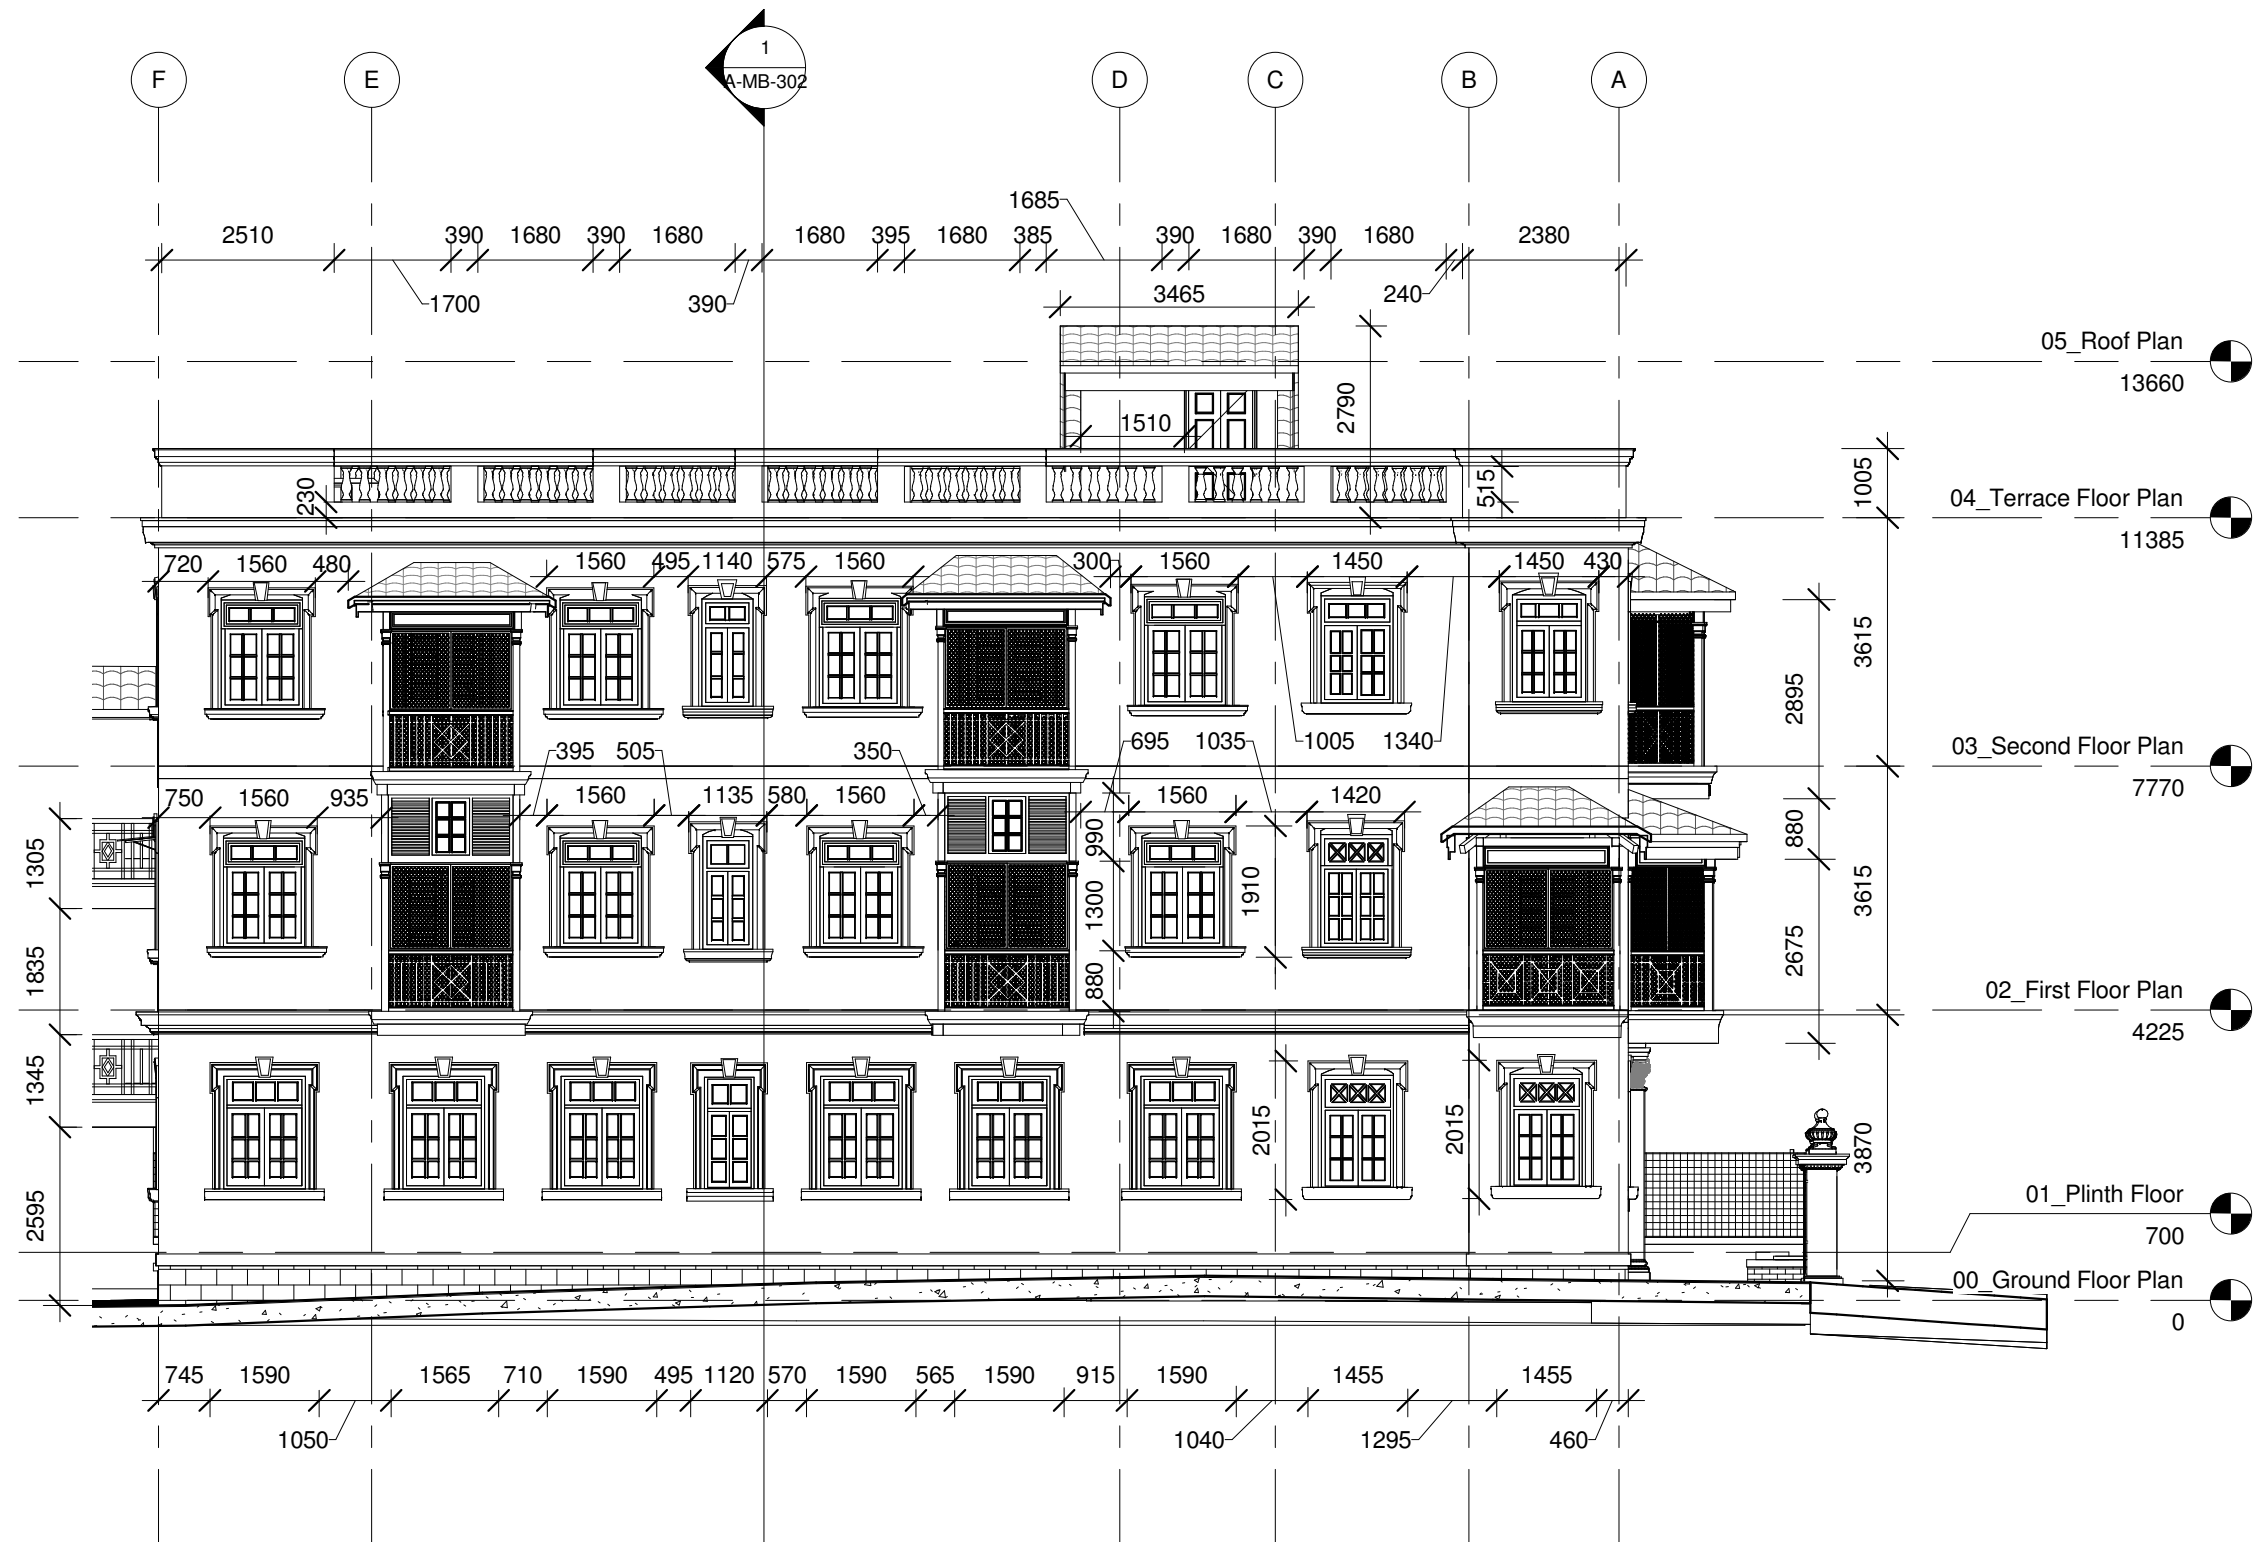


0	First Issue	03 Oct 2019
Rev.No	Purpose of Issue	Date
R E V I S I O N		
TITLE:- Main Building - North Elevation		
PROJECT:- Gandhi Heritage Sites Mission, Ministry of Culture, Govt. of India		
SITE:- Mani Bhavan 19, Laburnum Rd, near Police Station, Babulnath, Gamdevi. Mumbai, Maharashtra - 400007 INDIA		
SCALE:- 1 : 100	DRG.No	REV.
DATE:- 03-10-2019	A-MB-201	0
Size:- A3		
Executed By: Sabarmati Ashram Preservation and Memorial Trust, Ahmedabad 380027, Gujarat - INDIA		
Technical Implementation Agency: SHAYONA MANAGEMENT SERVICES PVT. LTD. 4th Floor, Om Shayona Arcade, Nr.Silver Oak College of Engg.&Tech Gota,Ahmedabad - 382181 Gujarat, INDIA. Phone : +91 9925204263 Email : info@shayonamanagement.com Web : www.shayonamanagement.com		

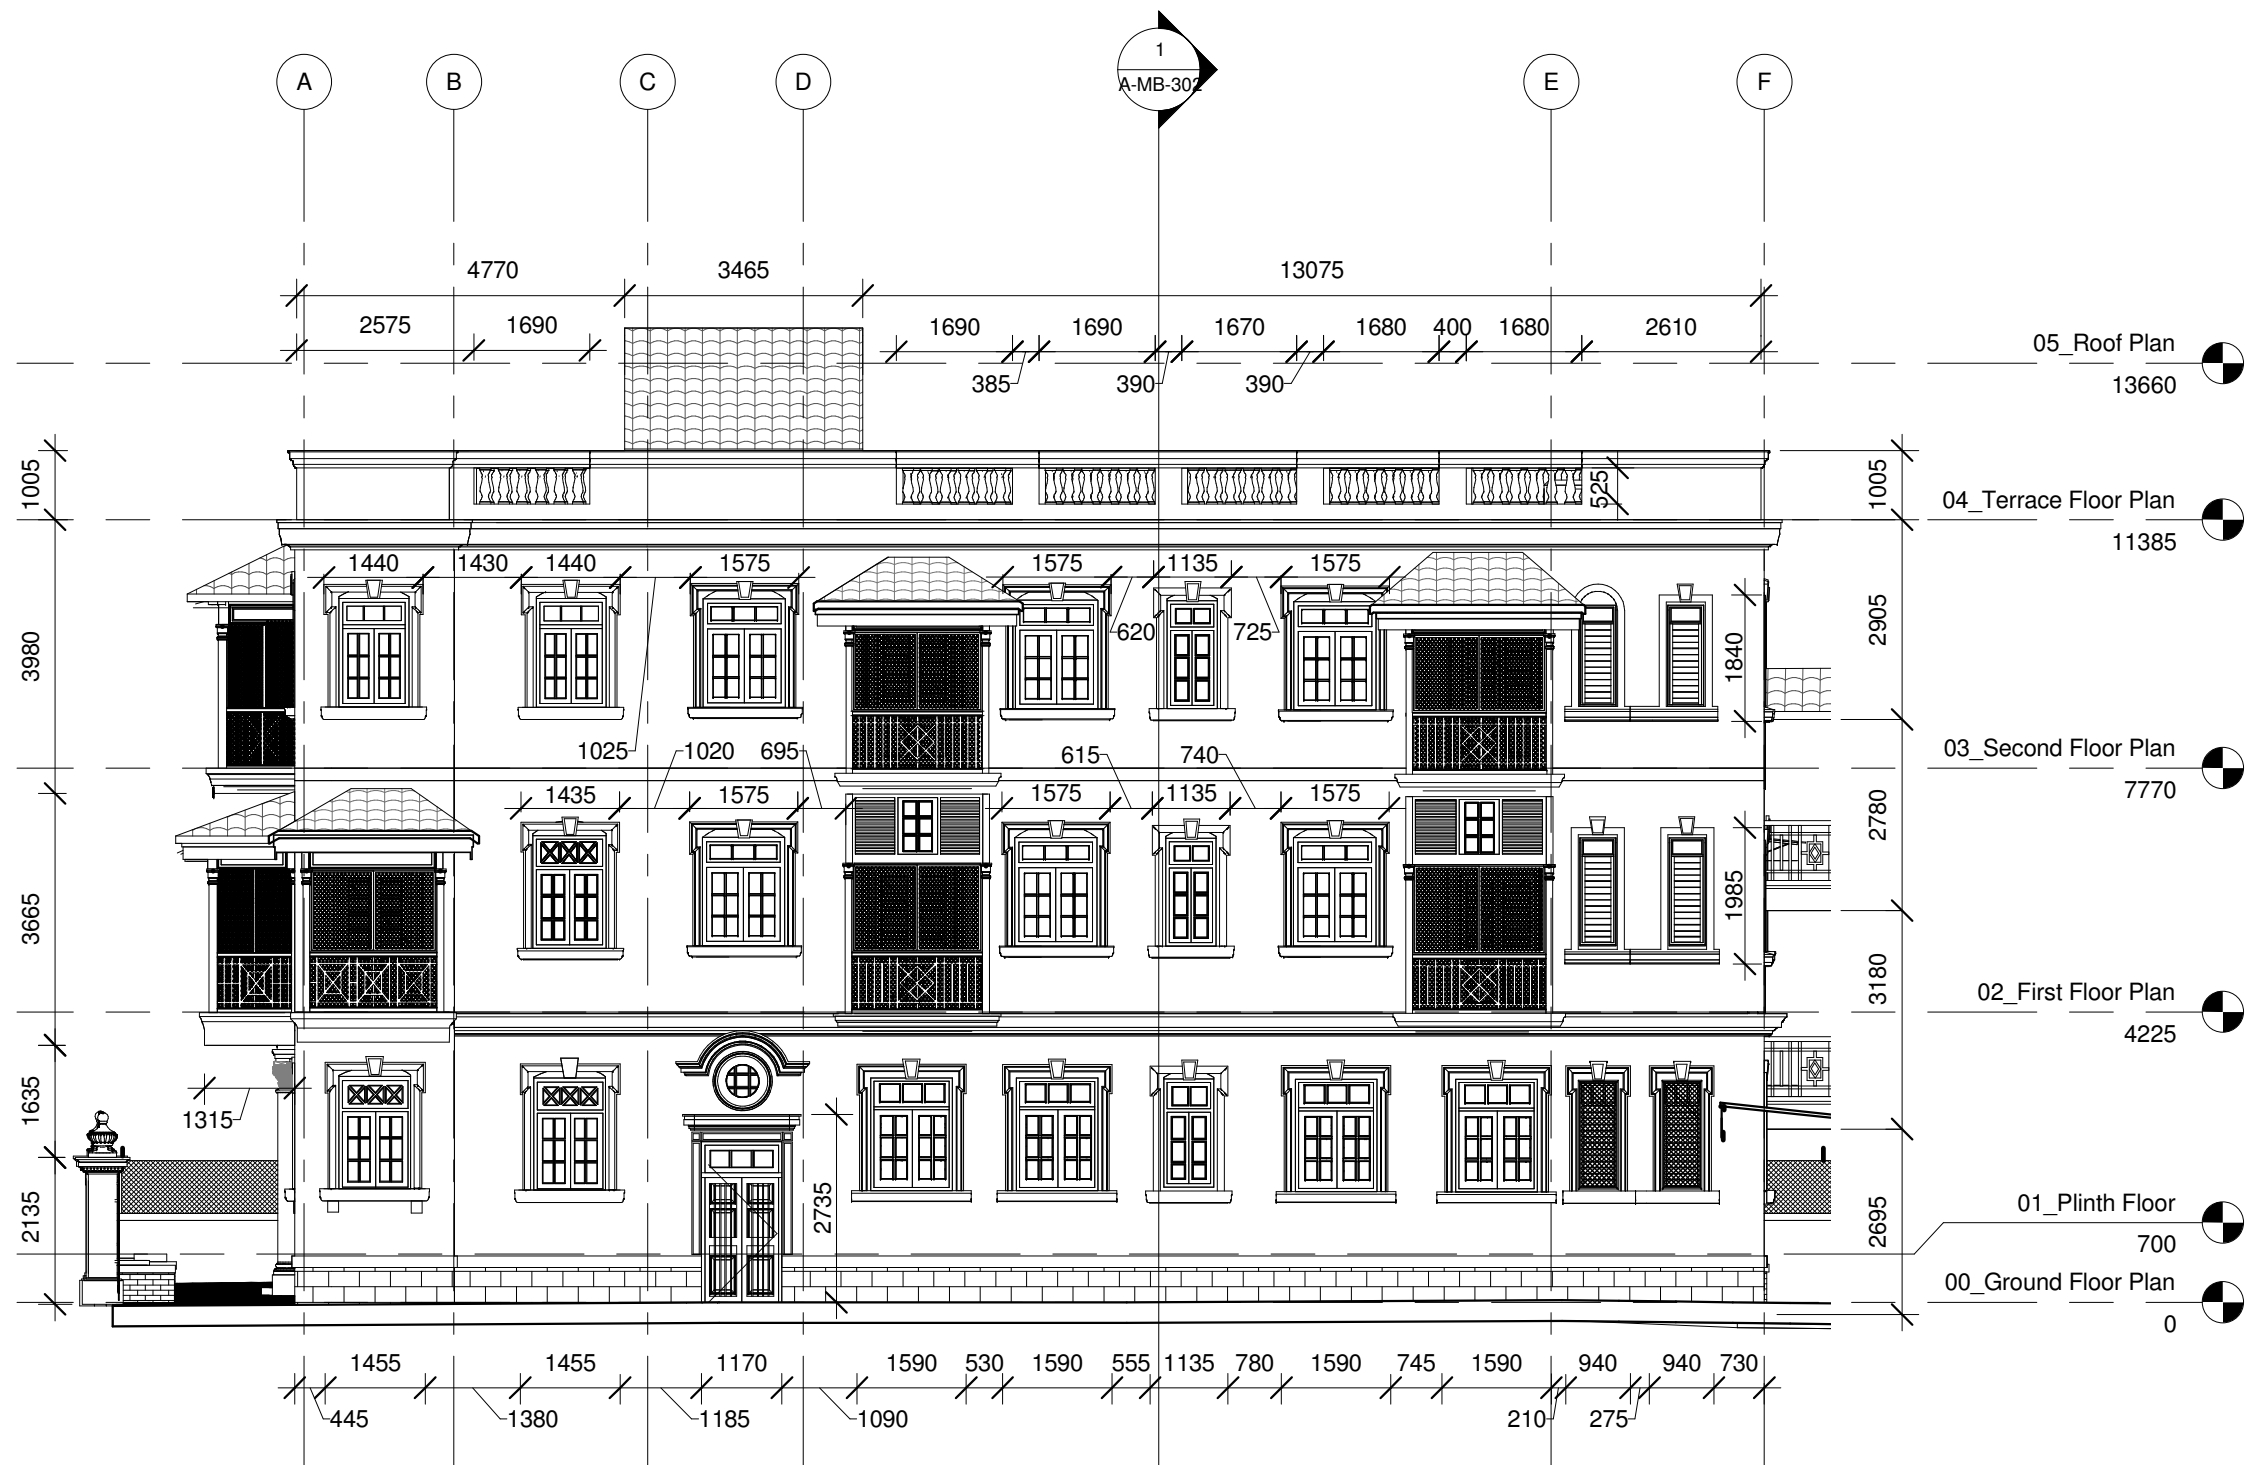


1 MB_South Elevation
1 : 100

0	First Issue	03 Oct 2019
Rev.No	Purpose of Issue	Date
R E V I S I O N		
TITLE:- Main Building - South Elevation		
PROJECT:- Gandhi Heritage Sites Mission, Ministry of Culture, Govt. of India		
SITE:- Mani Bhavan 19, Laburnum Rd, near Police Station, Babulnath, Gamdevi. Mumbai, Maharastra - 400007 INDIA		
SCALE:- 1 : 100	DRG.No	REV.
DATE:- 03-10-2019	A-MB-202	0
Size:- A3		
Executed By: Sabarmati Ashram Preservation and Memorial Trust, Ahmedabad 380027, Gujarat - INDIA		
Technical Implementation Agency: SHAYONA MANAGEMENT SERVICES PVT. LTD. 4th Floor, Om Shayona Arcade, Nr.Silver Oak College of Engg.&Tech Gota,Ahmedabad - 382181 Gujarat, INDIA. Phone : +91 9925204263 Email : info@shayonamanagement.com Web : www.shayonamanagement.com		

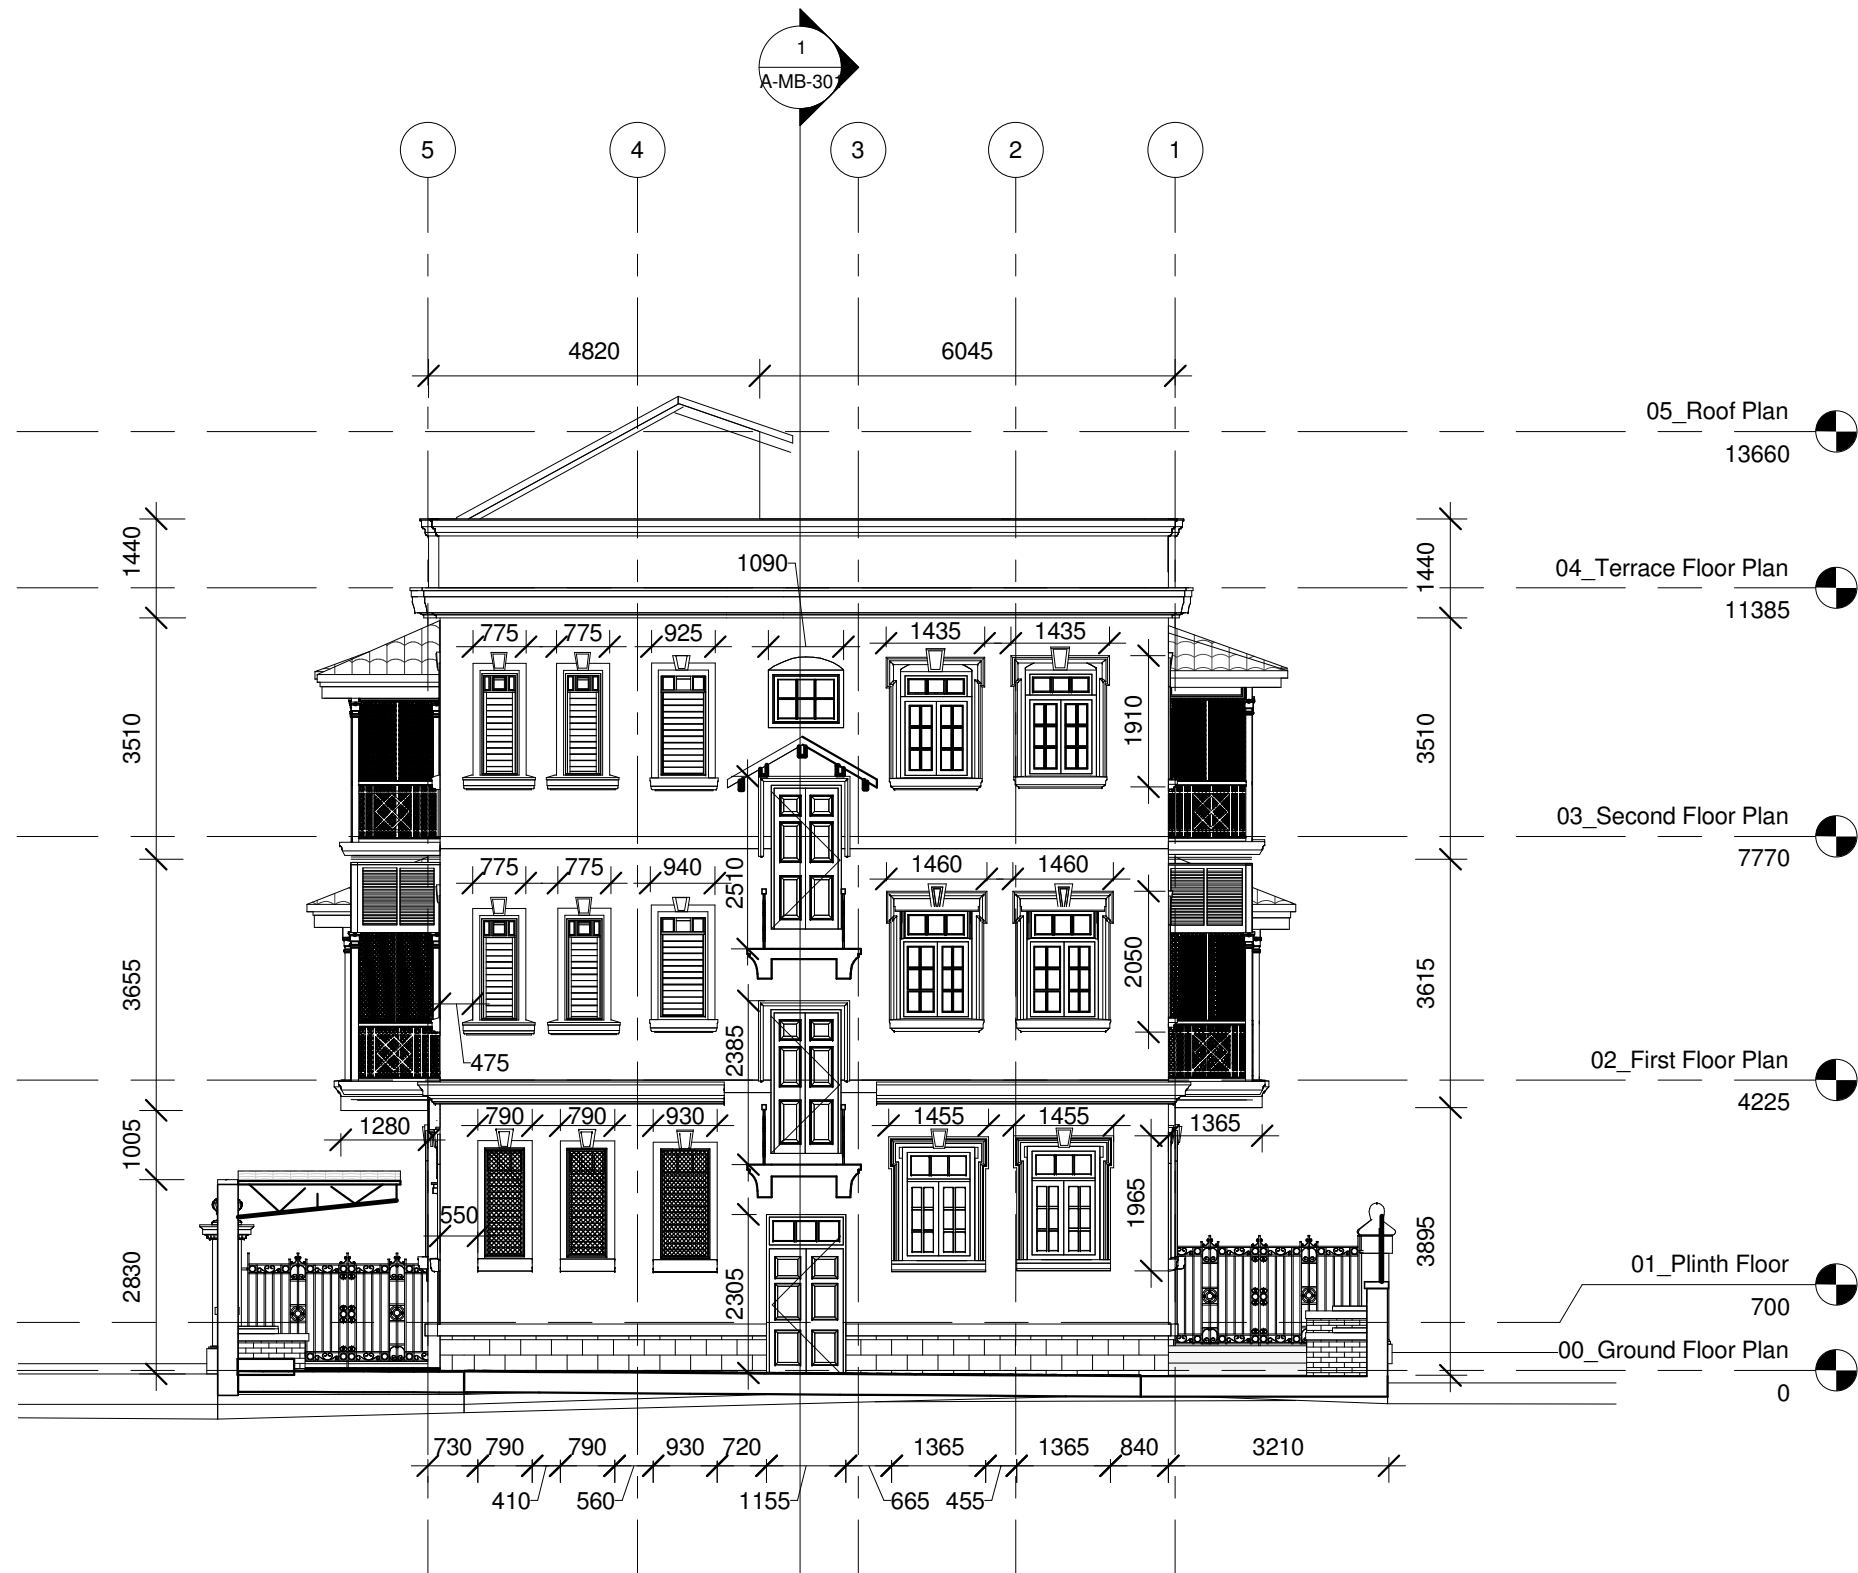

1 MB_East Elevation
1 : 100

0	First Issue	03 Oct 2019
Rev.No	Purpose of Issue	Date
R E V I S I O N		
TITLE:- Main Building - East Elevation		
PROJECT:- Gandhi Heritage Sites Mission, Ministry of Culture, Govt. of India		
SITE:- Mani Bhavan 19, Laburnum Rd, near Police Station, Babulnath, Gamdevi. Mumbai, Maharastra - 400007 INDIA		
SCALE:- 1 : 100	DRG.No	REV.
DATE:- 03-10-2019	A-MB-203	0
Size:- A3		
Executed By: Sabarmati Ashram Preservation and Memorial Trust, Ahmedabad 380027, Gujarat - INDIA		
Technical Implementation Agency: SHAYONA MANAGEMENT SERVICES PVT. LTD. 4th Floor, Om Shayona Arcade, Nr.Silver Oak College of Engg.&Tech Gota,Ahmedabad - 382181 Gujarat, INDIA. Phone : +91 9925204263 Email : info@shayonamanagement.com Web : www.shayonamanagement.com		

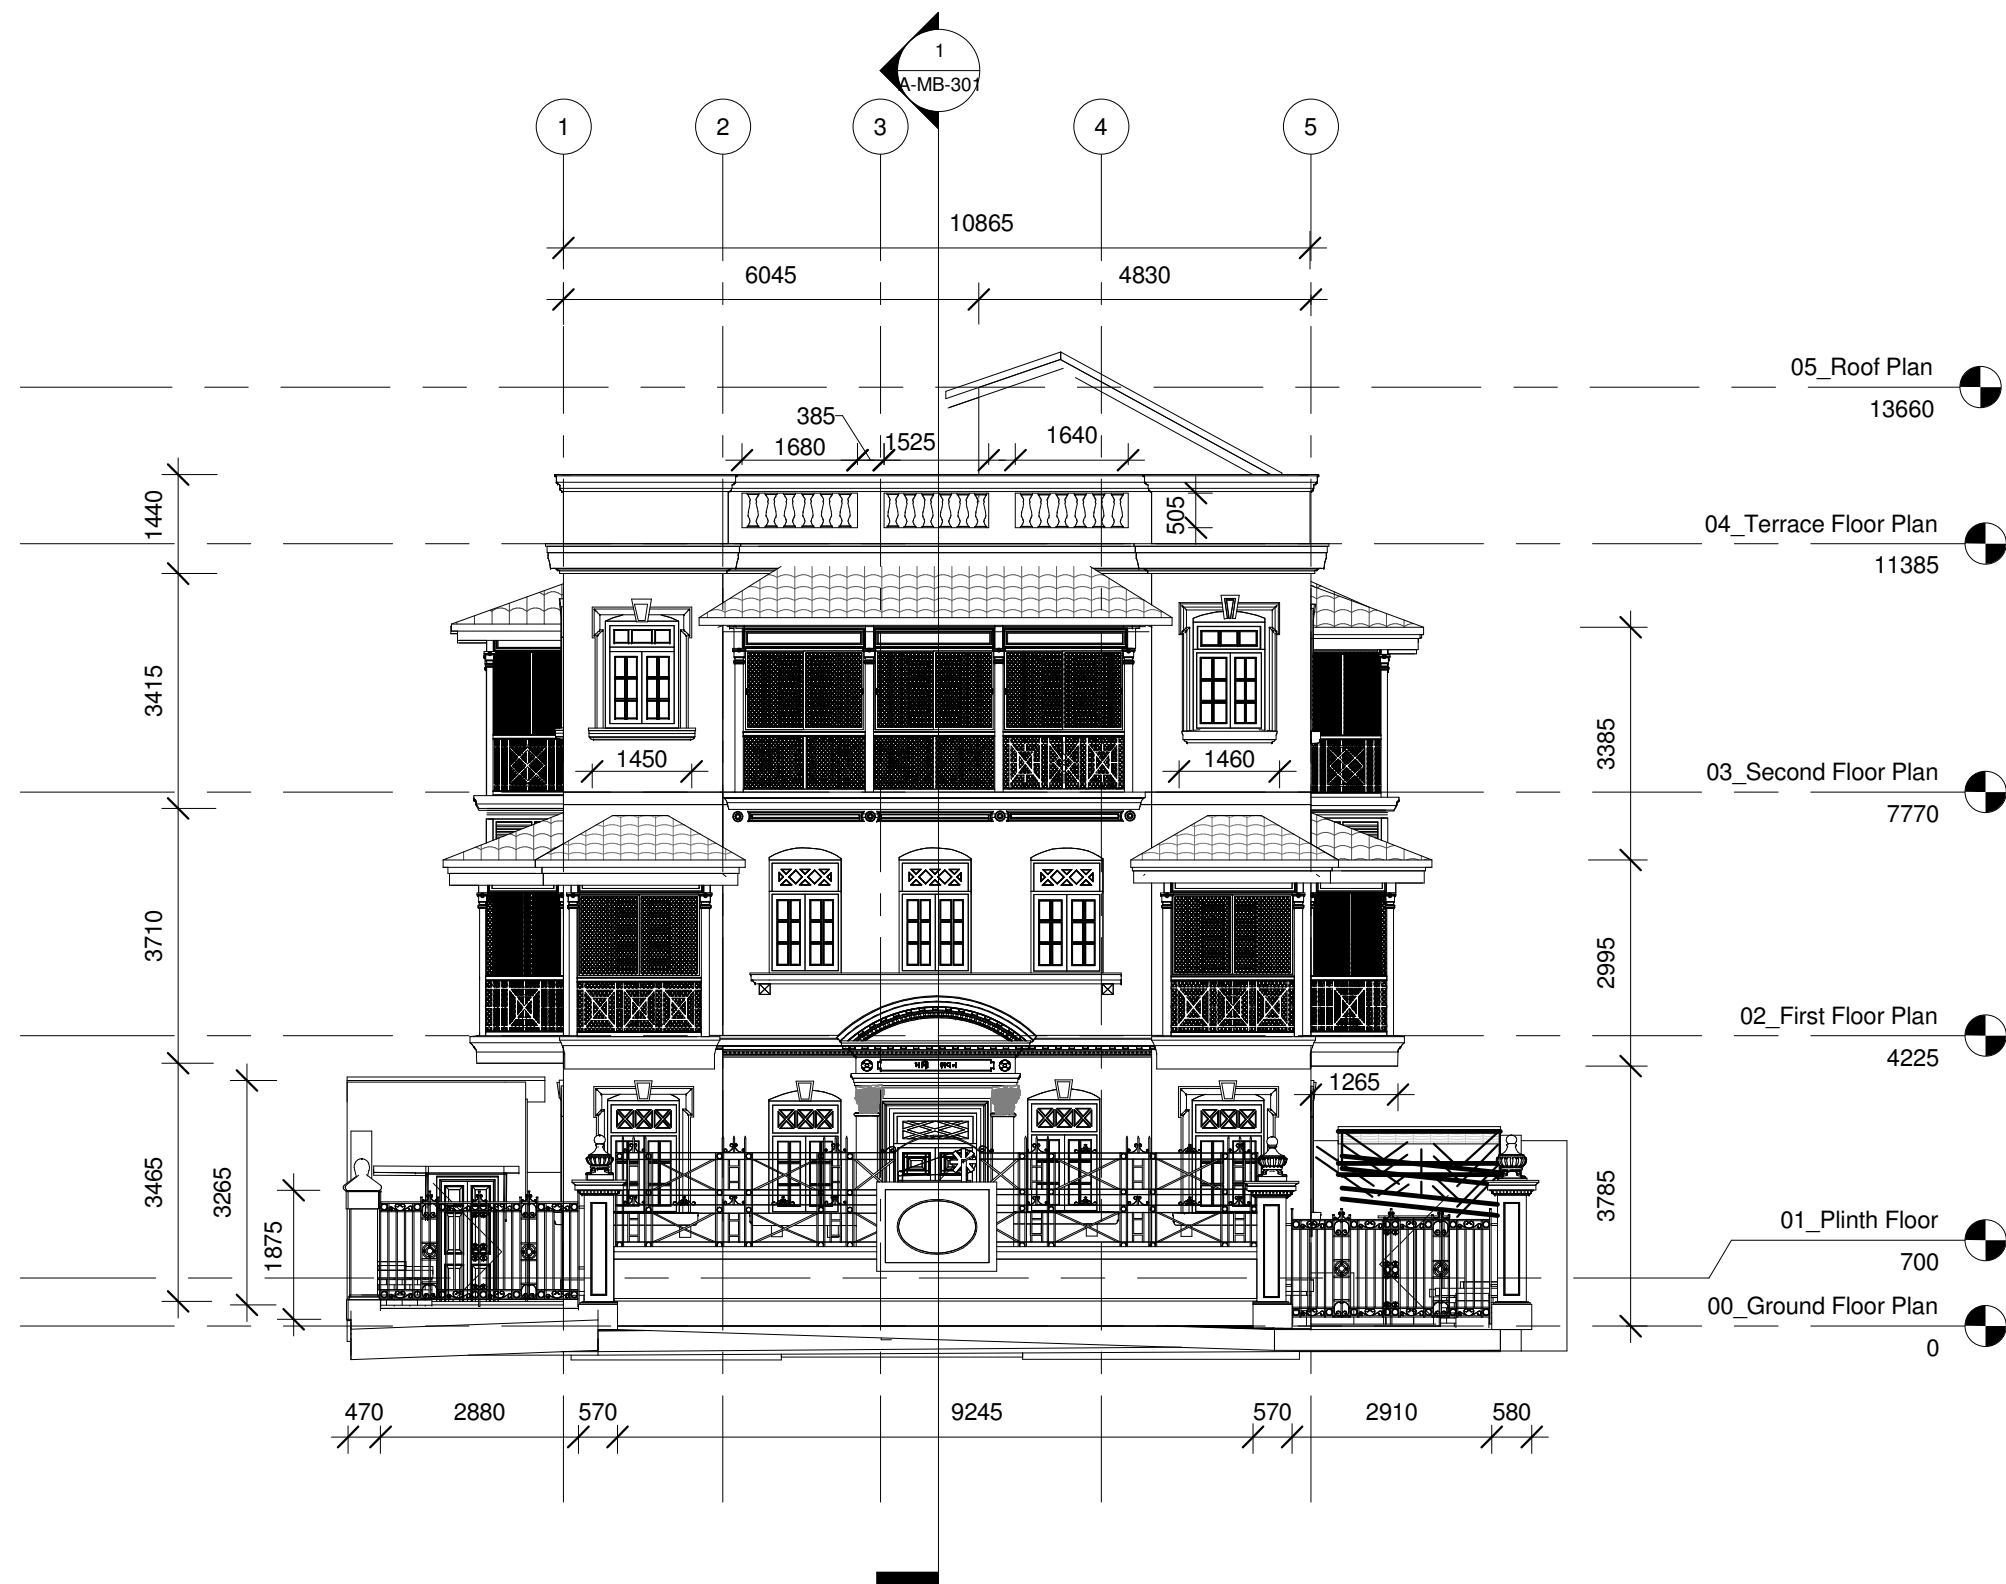

1 MB_West Elevation
1 : 100

05_Roof Plan
13660

04_Terrace Floor Plan
11385


03_Second Floor Plan
7770

02_First Floor Plan
4225

01_Plinth Floor
700


00_Ground Floor Plan
0

0	First Issue	03 Oct 2019
Rev.No	Purpose of Issue	Date
R E V I S I O N		
TITLE:- Main Building - West Elevation		
PROJECT:- Gandhi Heritage Sites Mission, Ministry of Culture, Govt. of India		
SITE:- Mani Bhavan 19, Laburnum Rd, near Police Station, Babulnath, Gamdevi. Mumbai, Maharastra - 400007 INDIA		
SCALE:- 1 : 100	DRG.No	REV.
DATE:- 03-10-2019	A-MB-204	0
Size:- A3		
Executed By: Sabarmati Ashram Preservation and Memorial Trust, Ahmedabad 380027, Gujarat - INDIA		
Technical Implementation Agency: SHAYONA MANAGEMENT SERVICES PVT. LTD. 4th Floor, Om Shayona Arcade, Nr.Silver Oak College of Engg.&Tech Gota,Ahmedabad - 382181 Gujarat, INDIA. Phone : +91 9925204263 Email : info@shayonamanagement.com Web : www.shayonamanagement.com		

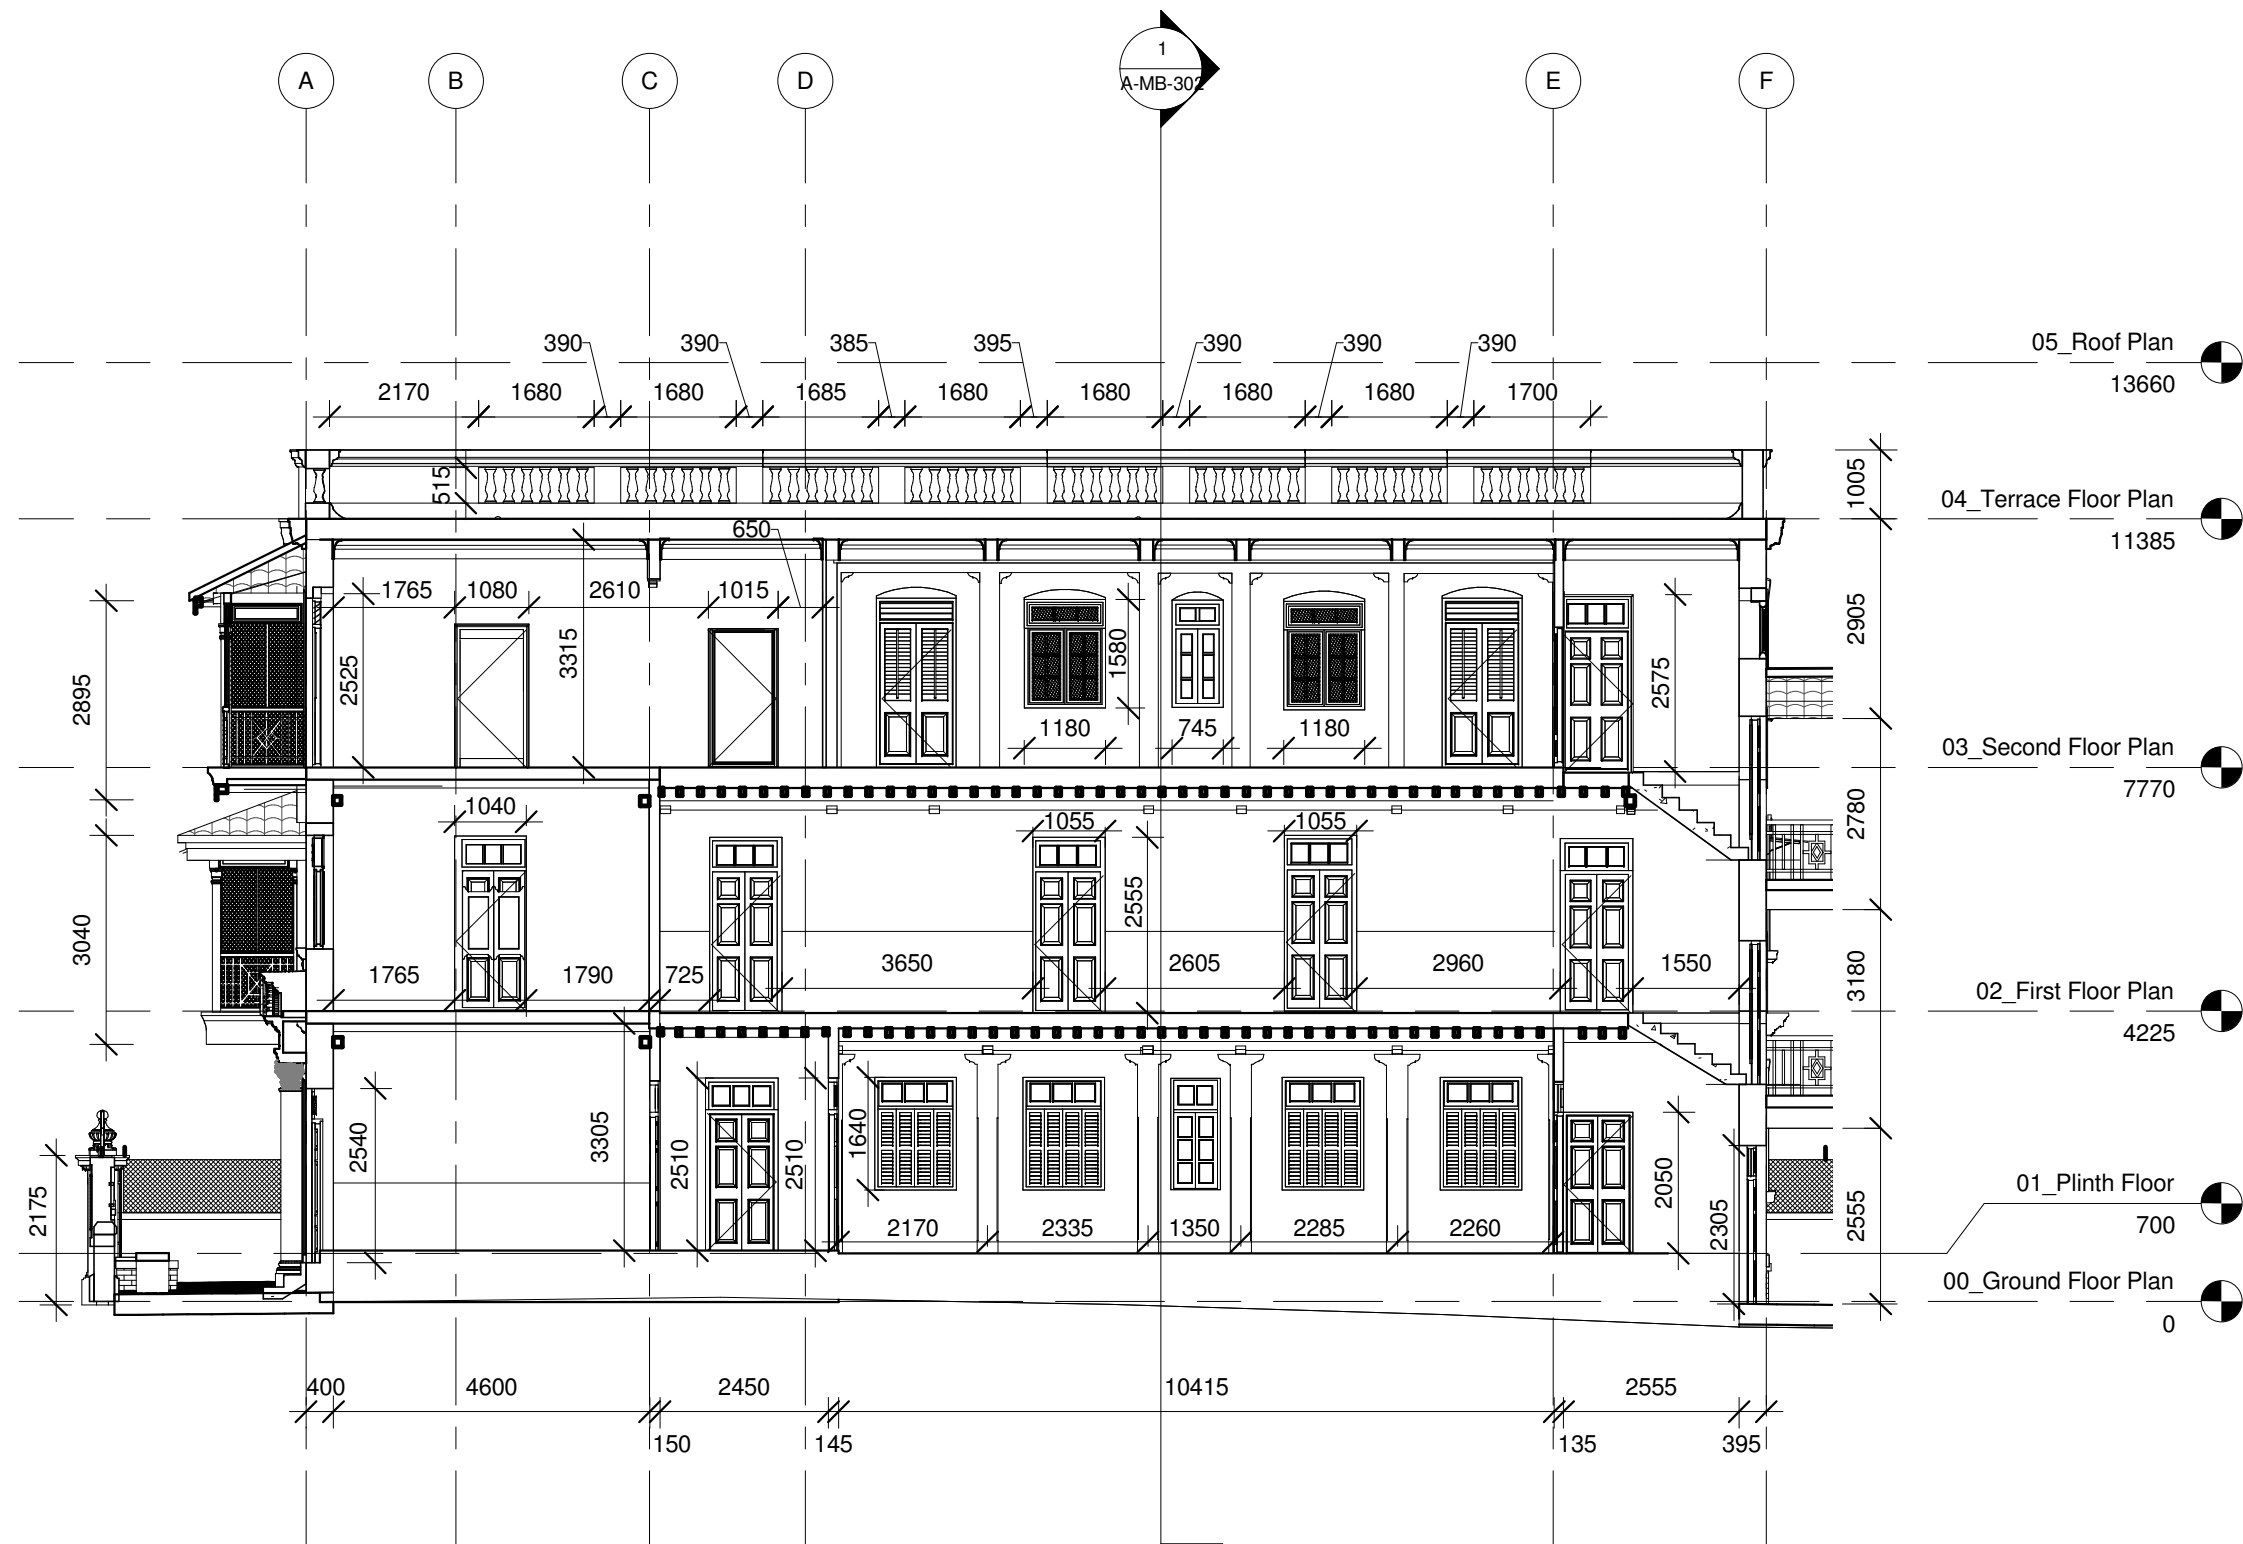


1 MB_Section A-A
1 : 100

0	First Issue	03 Oct 2019
Rev.No	Purpose of Issue	Date
R E V I S I O N		
TITLE:- Main Building - Section A-A		
PROJECT:- Gandhi Heritage Sites Mission, Ministry of Culture, Govt. of India		
SITE:- Mani Bhavan 19, Laburnum Rd, near Police Station, Babulnath, Gamdevi. Mumbai, Maharastra - 400007 INDIA		
SCALE:- 1 : 100	DRG.No	REV.
DATE:- 03-10-2019	A-MB-301	0
Size:- A3		
Executed By: Sabarmati Ashram Preservation and Memorial Trust, Ahmedabad 380027, Gujarat - INDIA		
Technical Implementation Agency: SHAYONA MANAGEMENT SERVICES PVT. LTD. 4th Floor, Om Shayona Arcade, Nr.Silver Oak College of Engg.&Tech Gota,Ahmedabad - 382181 Gujarat, INDIA. Phone : +91 9925204263 Email : info@shayonamanagement.com Web : www.shayonamanagement.com		

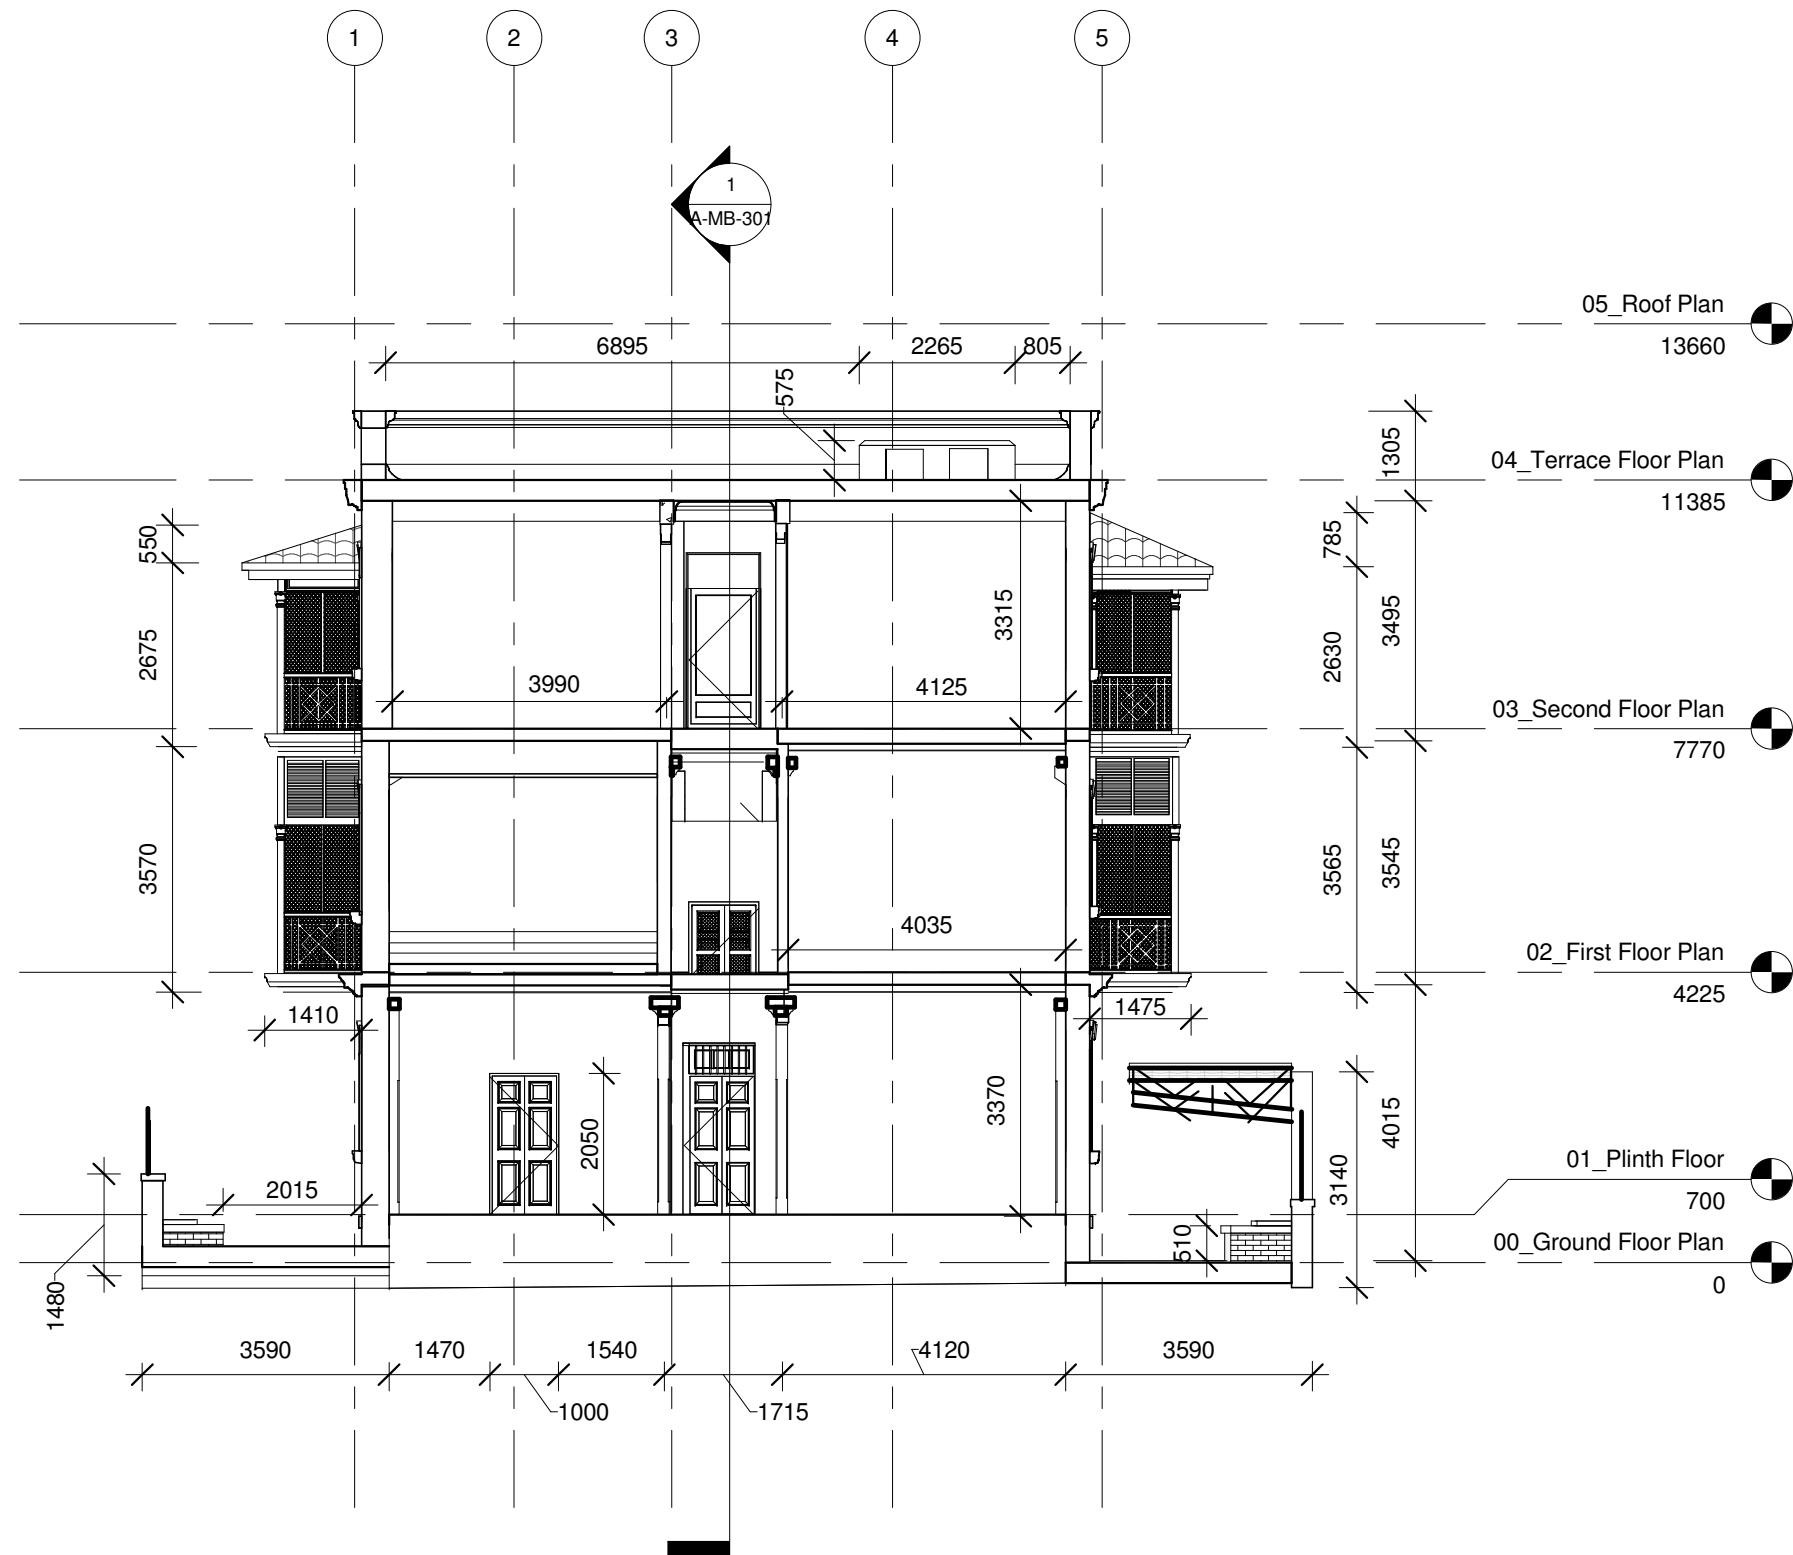


1 MB_Section B-B
1 : 100

0	First Issue	03 Oct 2019	
Rev.No	Purpose of Issue	Date	
R E V I S I O N			
TITLE:- Main Building - Section B-B			
PROJECT:- Gandhi Heritage Sites Mission, Ministry of Culture, Govt. of India			
SITE:- Mani Bhavan 19, Laburnum Rd, near Police Station, Babulnath, Gamdevi. Mumbai, Maharastra - 400007 INDIA			
SCALE:- 1 : 100		DRG.No	REV.
DATE:- 03-10-2019		A-MB-302	0
Size:- A3			
Executed By: Sabarmati Ashram Preservation and Memorial Trust, Ahmedabad 380027, Gujarat - INDIA			
Technical Implementation Agency: SHAYONA MANAGEMENT SERVICES PVT. LTD. 4th Floor, Om Shayona Arcade, Nr.Silver Oak College of Engg.&Tech Gota,Ahmedabad - 382181 Gujarat, INDIA. Phone : +91 9925204263 Email : info@shayonamanagement.com Web : www.shayonamanagement.com			

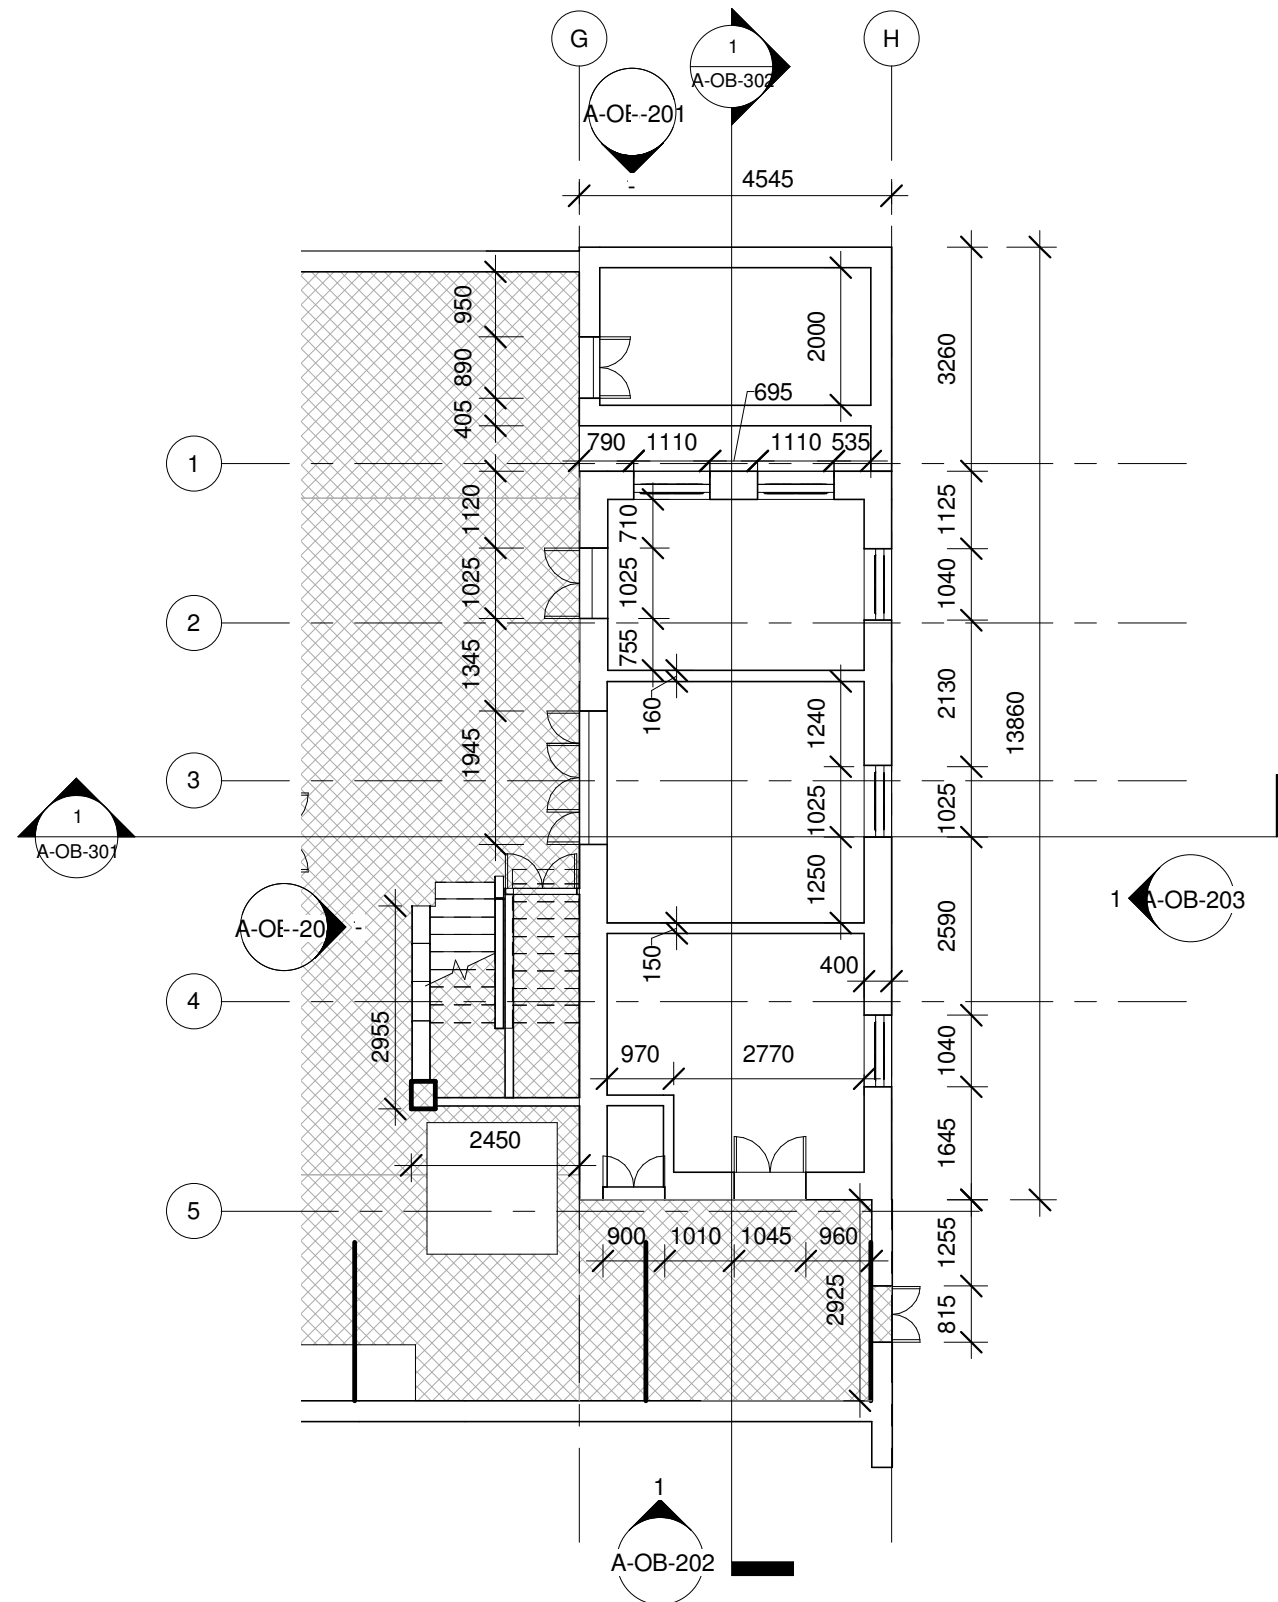


1 OB_00_Ground Floor Plan
1 : 100

0	First Issue	03 Oct 2019
Rev.No	Purpose of Issue	Date
R	E	V
I	S	I
O	N	
TITLE:- Old Building - Ground Floor Plan		
PROJECT:- Gandhi Heritage Sites Mission, Ministry of Culture, Govt. of India		
SITE:- Mani Bhavan 19, Laburnum Rd, near Police Station, Babulnath, Gamdevi. Mumbai, Maharastra - 400007 INDIA		
SCALE:- 1 : 100		DRG.No
DATE:- 03-10-2019		REV.
Size:- A3		0
A-OB-102		
0		
Executed By: Sabarmati Ashram Preservation and Memorial Trust, Ahmedabad 380027, Gujarat - INDIA		
Technical Implementation Agency: SHAYONA MANAGEMENT SERVICES PVT. LTD. 4th Floor, Om Shayona Arcade, Nr.Silver Oak College of Engg.&Tech Gota,Ahmedabad - 382181 Gujarat, INDIA. Phone : +91 9925204263 Email : info@shayonamanagement.com Web : www.shayonamanagement.com		

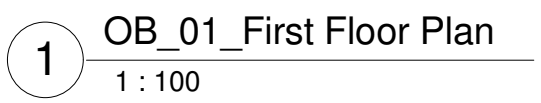


0	First Issue	03 Oct 2019
Rev.No	Purpose of Issue	Date
R	E	V
I	S	I
O	N	
TITLE:- Old Building - First Floor Plan		
PROJECT:- Gandhi Heritage Sites Mission, Ministry of Culture, Govt. of India		
SITE:- Mani Bhavan 19, Laburnum Rd, near Police Station, Babulnath, Gamdevi. Mumbai, Maharastra - 400007 INDIA		
SCALE:- 1 : 100		DRG.No
DATE:- 03-10-2019		REV.
Size:- A3		0
A-OB-103		
Executed By: Sabarmati Ashram Preservation and Memorial Trust, Ahmedabad 380027, Gujarat - INDIA		
Technical Implementation Agency: SHAYONA MANAGEMENT SERVICES PVT. LTD. 4th Floor, Om Shayona Arcade, Nr.Silver Oak College of Engg.&Tech Gota,Ahmedabad - 382181 Gujarat, INDIA. Phone : +91 9925204263 Email : info@shayonamangement.com Web : www.shayonamangement.com		

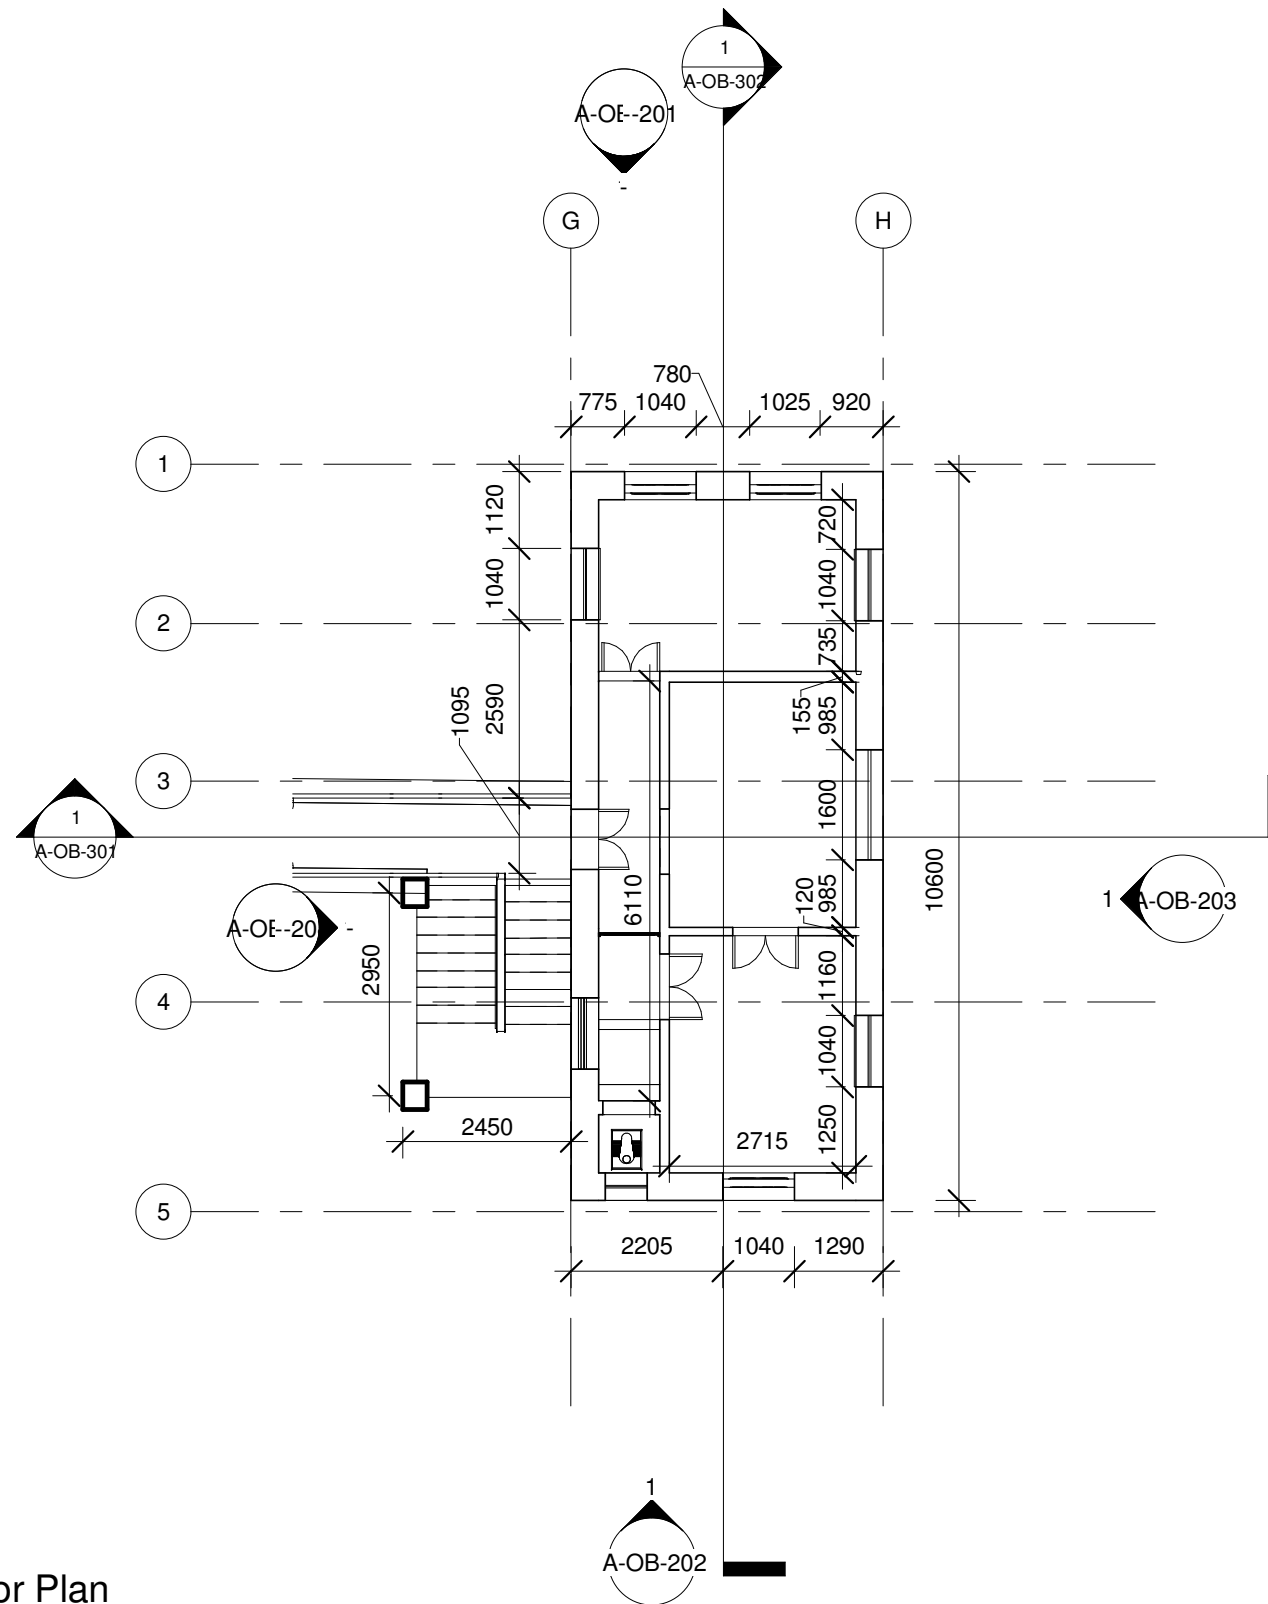


1 OB_02_Second Floor Plan
1 : 100

0	First Issue	03 Oct 2019
Rev.No	Purpose of Issue	Date
R	E	V
I	S	I
O	N	
TITLE:- Old Building - Second Floor Plan		
PROJECT:- Gandhi Heritage Sites Mission, Ministry of Culture, Govt. of India		
SITE:- Mani Bhavan 19, Laburnum Rd, near Police Station, Babulnath, Gamdevi. Mumbai, Maharastra - 400007 INDIA		
SCALE:- 1 : 100		DRG.No
DATE:- 03-10-2019		REV.
Size:- A3		0
A-OB-104		
0		
Executed By: Sabarmati Ashram Preservation and Memorial Trust, Ahmedabad 380027, Gujarat - INDIA		
Technical Implementation Agency: SHAYONA MANAGEMENT SERVICES PVT. LTD. 4th Floor, Om Shayona Arcade, Nr.Silver Oak College of Engg.&Tech Gota,Ahmedabad - 382181 Gujarat, INDIA. Phone : +91 9925204263 Email : info@shayonamanagement.com Web : www.shayonamanagement.com		

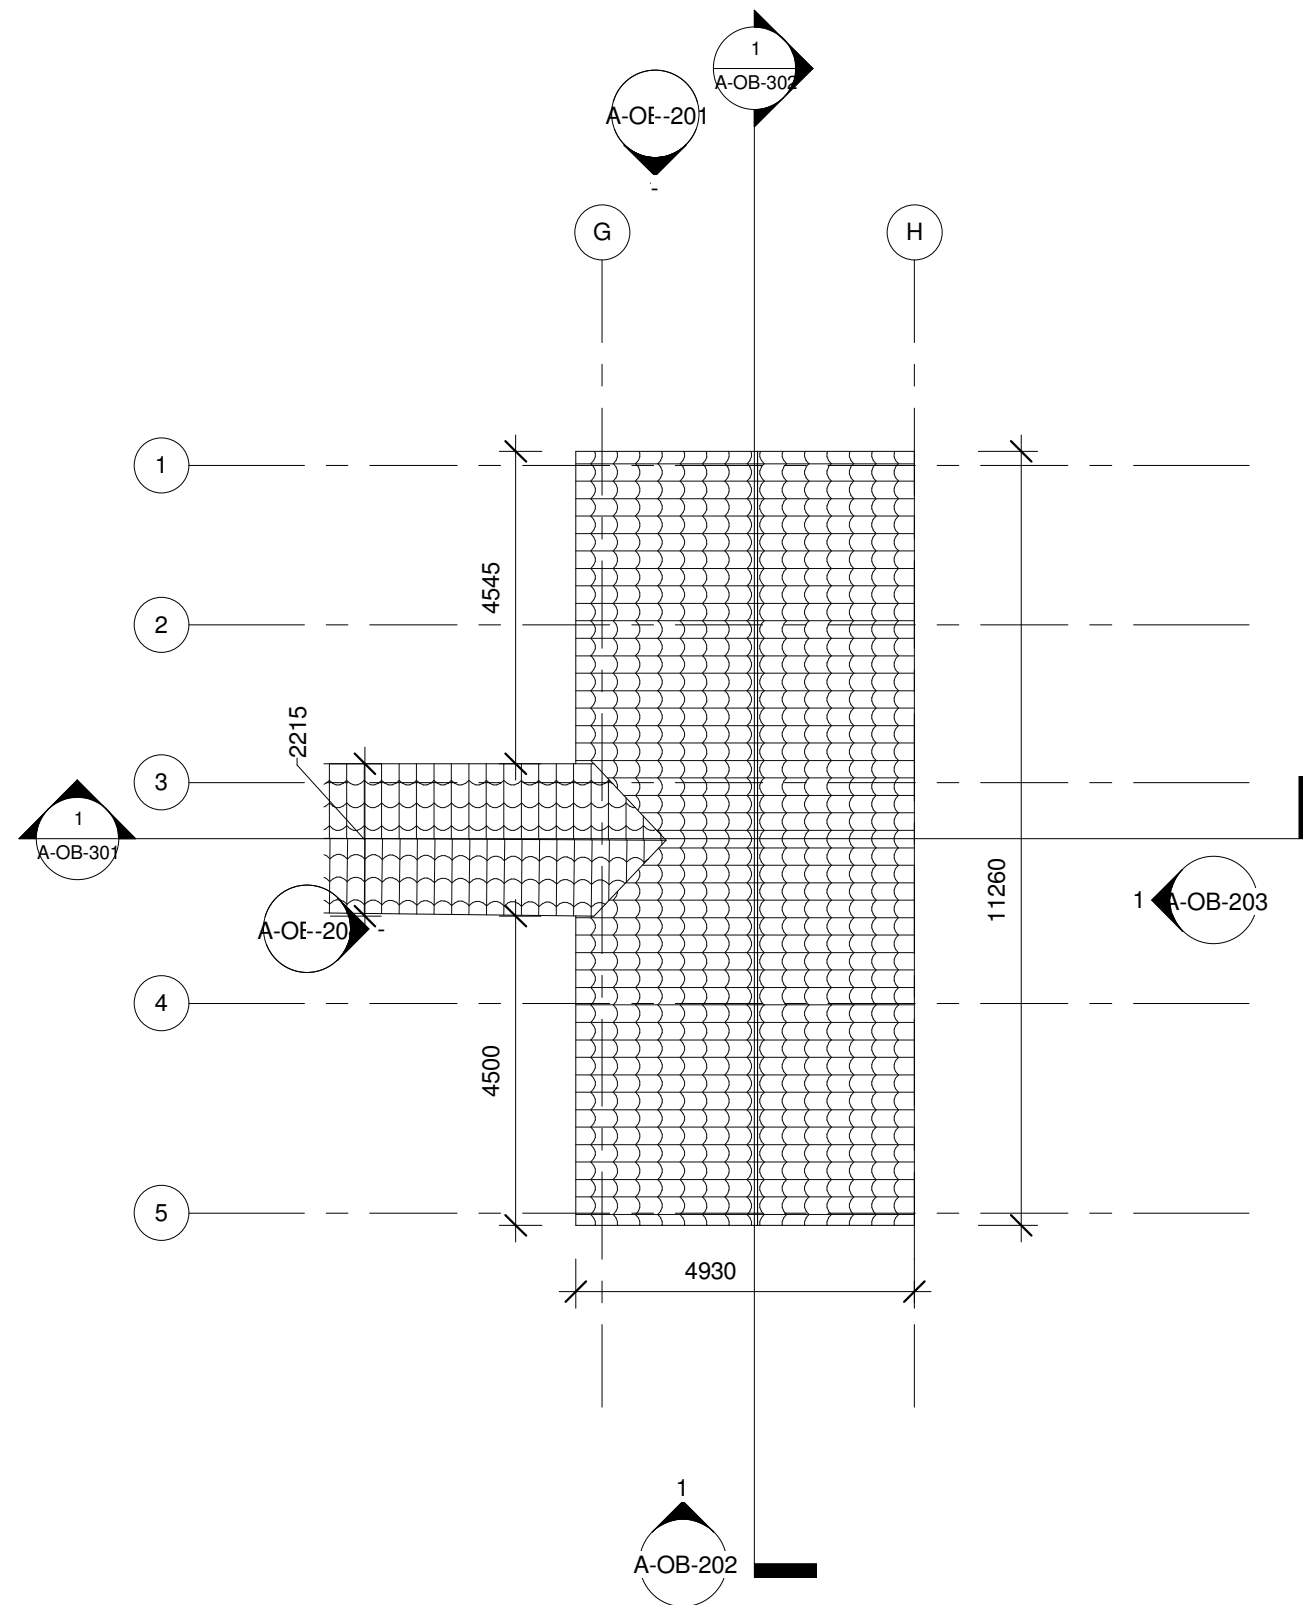

1 OB_03_Roof Plan
1 : 100


0	First Issue	03 Oct 2019
Rev.No	Purpose of Issue	Date
R	E	V
I	S	I
O	N	
TITLE:-		
Old Building - Roof Plan		
PROJECT:- Gandhi Heritage Sites Mission, Ministry of Culture, Govt. of India		
SITE:- Mani Bhavan 19, Laburnum Rd, near Police Station, Babulnath, Gamdevi. Mumbai, Maharastra - 400007 INDIA		
SCALE:- 1 : 100	DRG.No	REV.
DATE:- 03-10-2019	A-OB-105	0
Size:- A3		
Executed By:		
Sabarmati Ashram Preservation and Memorial Trust, Ahmedabad 380027, Gujarat - INDIA		
Technical Implementation Agency:		
SHAYONA MANAGEMENT SERVICES PVT. LTD.		
4th Floor, Om Shayona Arcade, Nr.Silver Oak College of Engg.&Tech Gota,Ahmedabad - 382181 Gujarat, INDIA. Phone : +91 9925204263 Email : info@shayonamanagement.com Web : www.shayonamanagement.com		

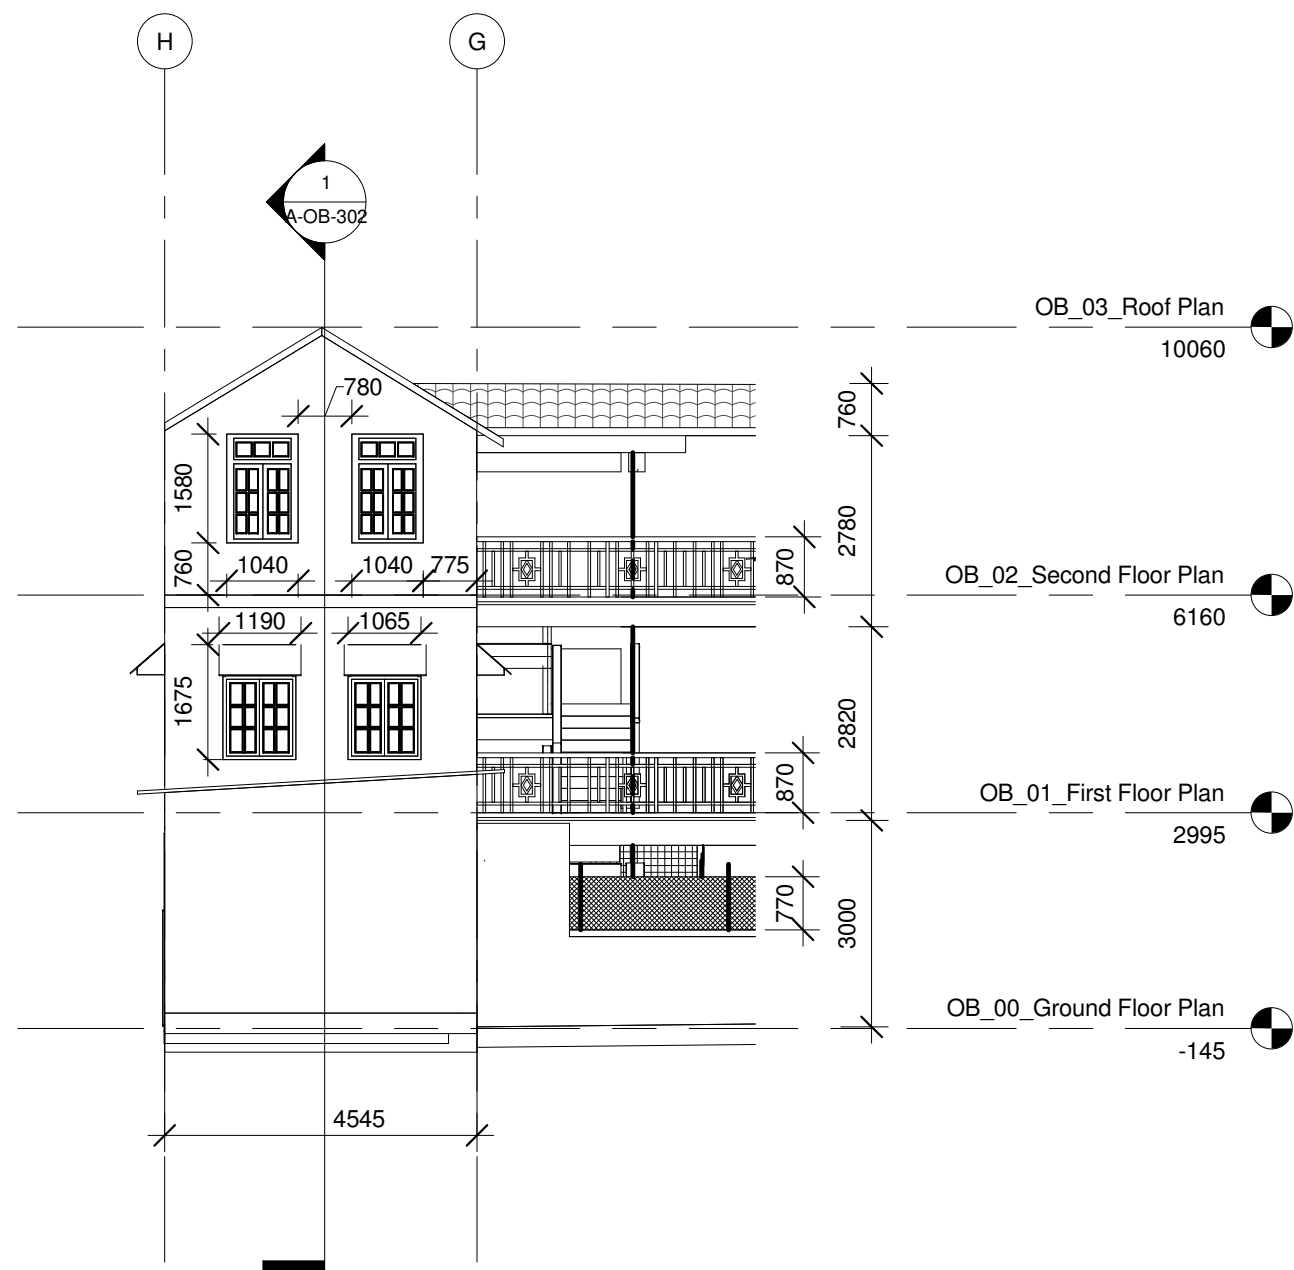


1 OB_North Elevation
1 : 100

0	First Issue	03 Oct 2019
Rev.No	Purpose of Issue	Date
R	E	V
I	S	I
O	N	
TITLE:- Old Building - North Elevation		
PROJECT:- Gandhi Heritage Sites Mission, Ministry of Culture, Govt. of India		
SITE:- Mani Bhavan 19, Laburnum Rd, near Police Station, Babulnath, Gamdevi. Mumbai, Maharashtra - 400007 INDIA		
SCALE:- 1 : 100	DRG.No	REV.
DATE:- 03-10-2019	A-OB-201	0
Size:- A3		
Executed By: Sabarmati Ashram Preservation and Memorial Trust, Ahmedabad 380027, Gujarat - INDIA		
Technical Implementation Agency: SHAYONA MANAGEMENT SERVICES PVT. LTD. 4th Floor, Om Shayona Arcade, Nr.Silver Oak College of Engg.&Tech Gota,Ahmedabad - 382181 Gujarat, INDIA. Phone : +91 9925204263 Email : info@shayonamanagement.com Web : www.shayonamanagement.com		

1 OB_South Elevation
1 : 100

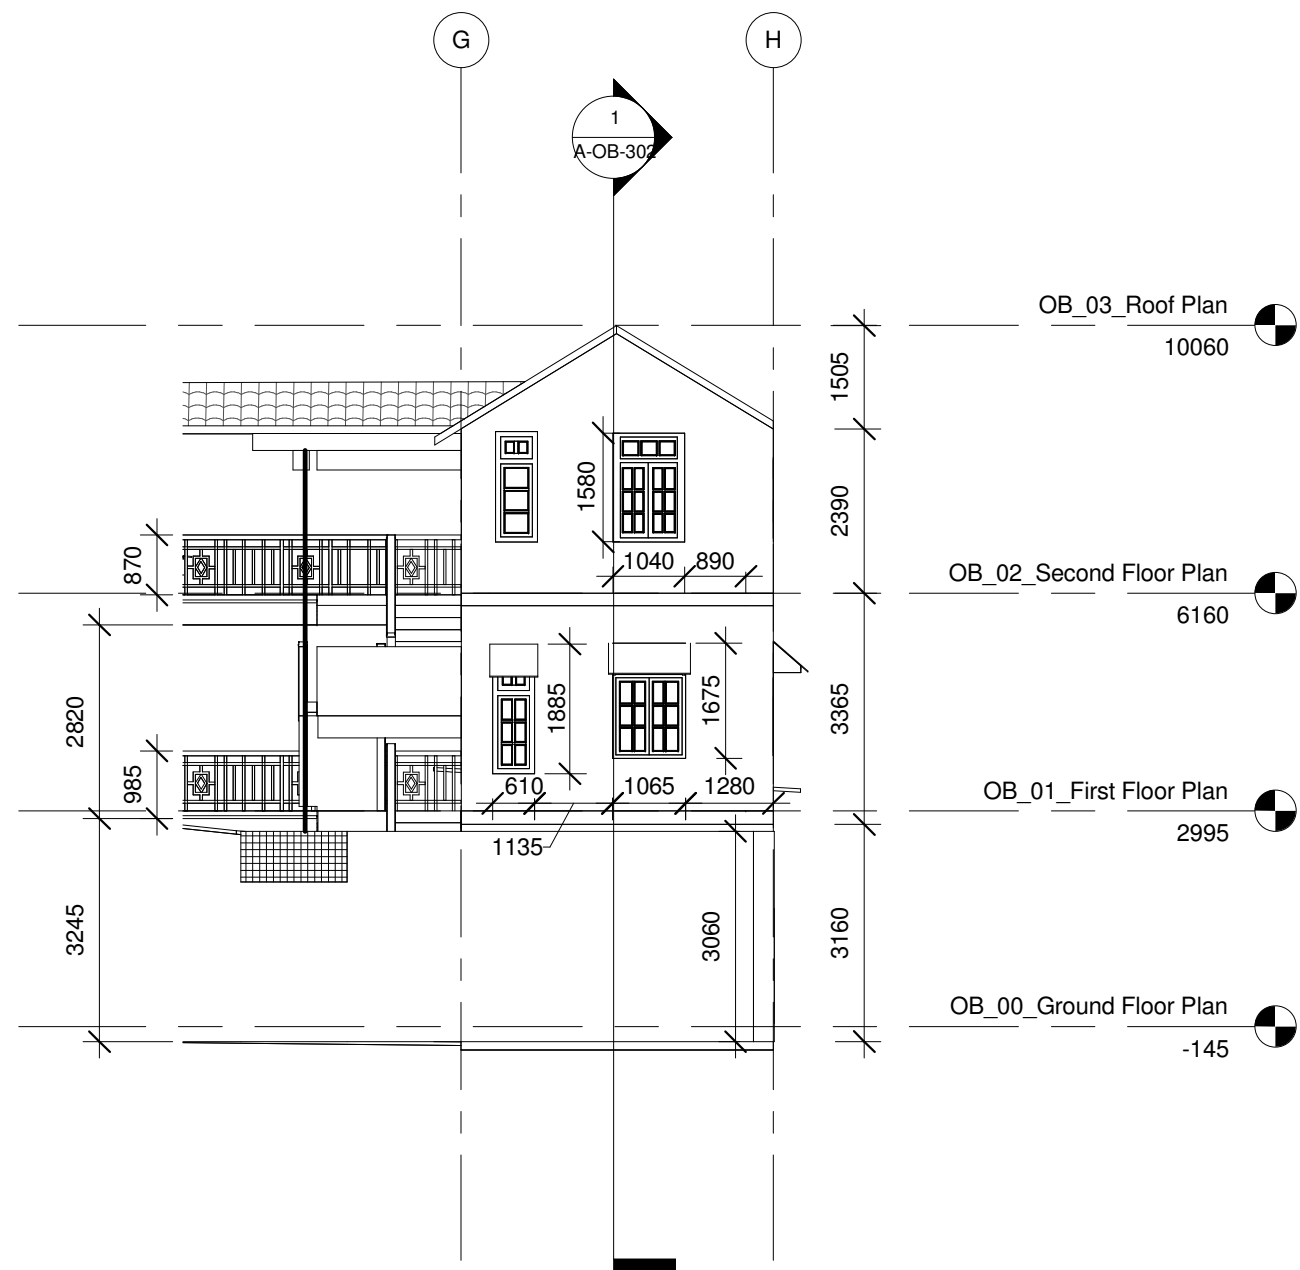


0	First Issue	03 Oct 2019
Rev.No	Purpose of Issue	Date
R	E	V
I	S	I
O	N	
TITLE:- Old Building - South Elevation		
PROJECT:- Gandhi Heritage Sites Mission, Ministry of Culture, Govt. of India		
SITE:- Mani Bhavan 19, Laburnum Rd, near Police Station, Babulnath, Gamdevi. Mumbai, Maharastra - 400007 INDIA		
SCALE:- 1 : 100		DRG.No
DATE:- 03-10-2019		REV.
Size:- A3		0
Executed By: Sabarmati Ashram Preservation and Memorial Trust, Ahmedabad 380027, Gujarat - INDIA		
Technical Implementation Agency: SHAYONA MANAGEMENT SERVICES PVT. LTD. 4th Floor, Om Shayona Arcade, Nr.Silver Oak College of Engg.&Tech Gota,Ahmedabad - 382181 Gujarat, INDIA. Phone : +91 9925204263 Email : info@shayonamanagement.com Web : www.shayonamanagement.com		

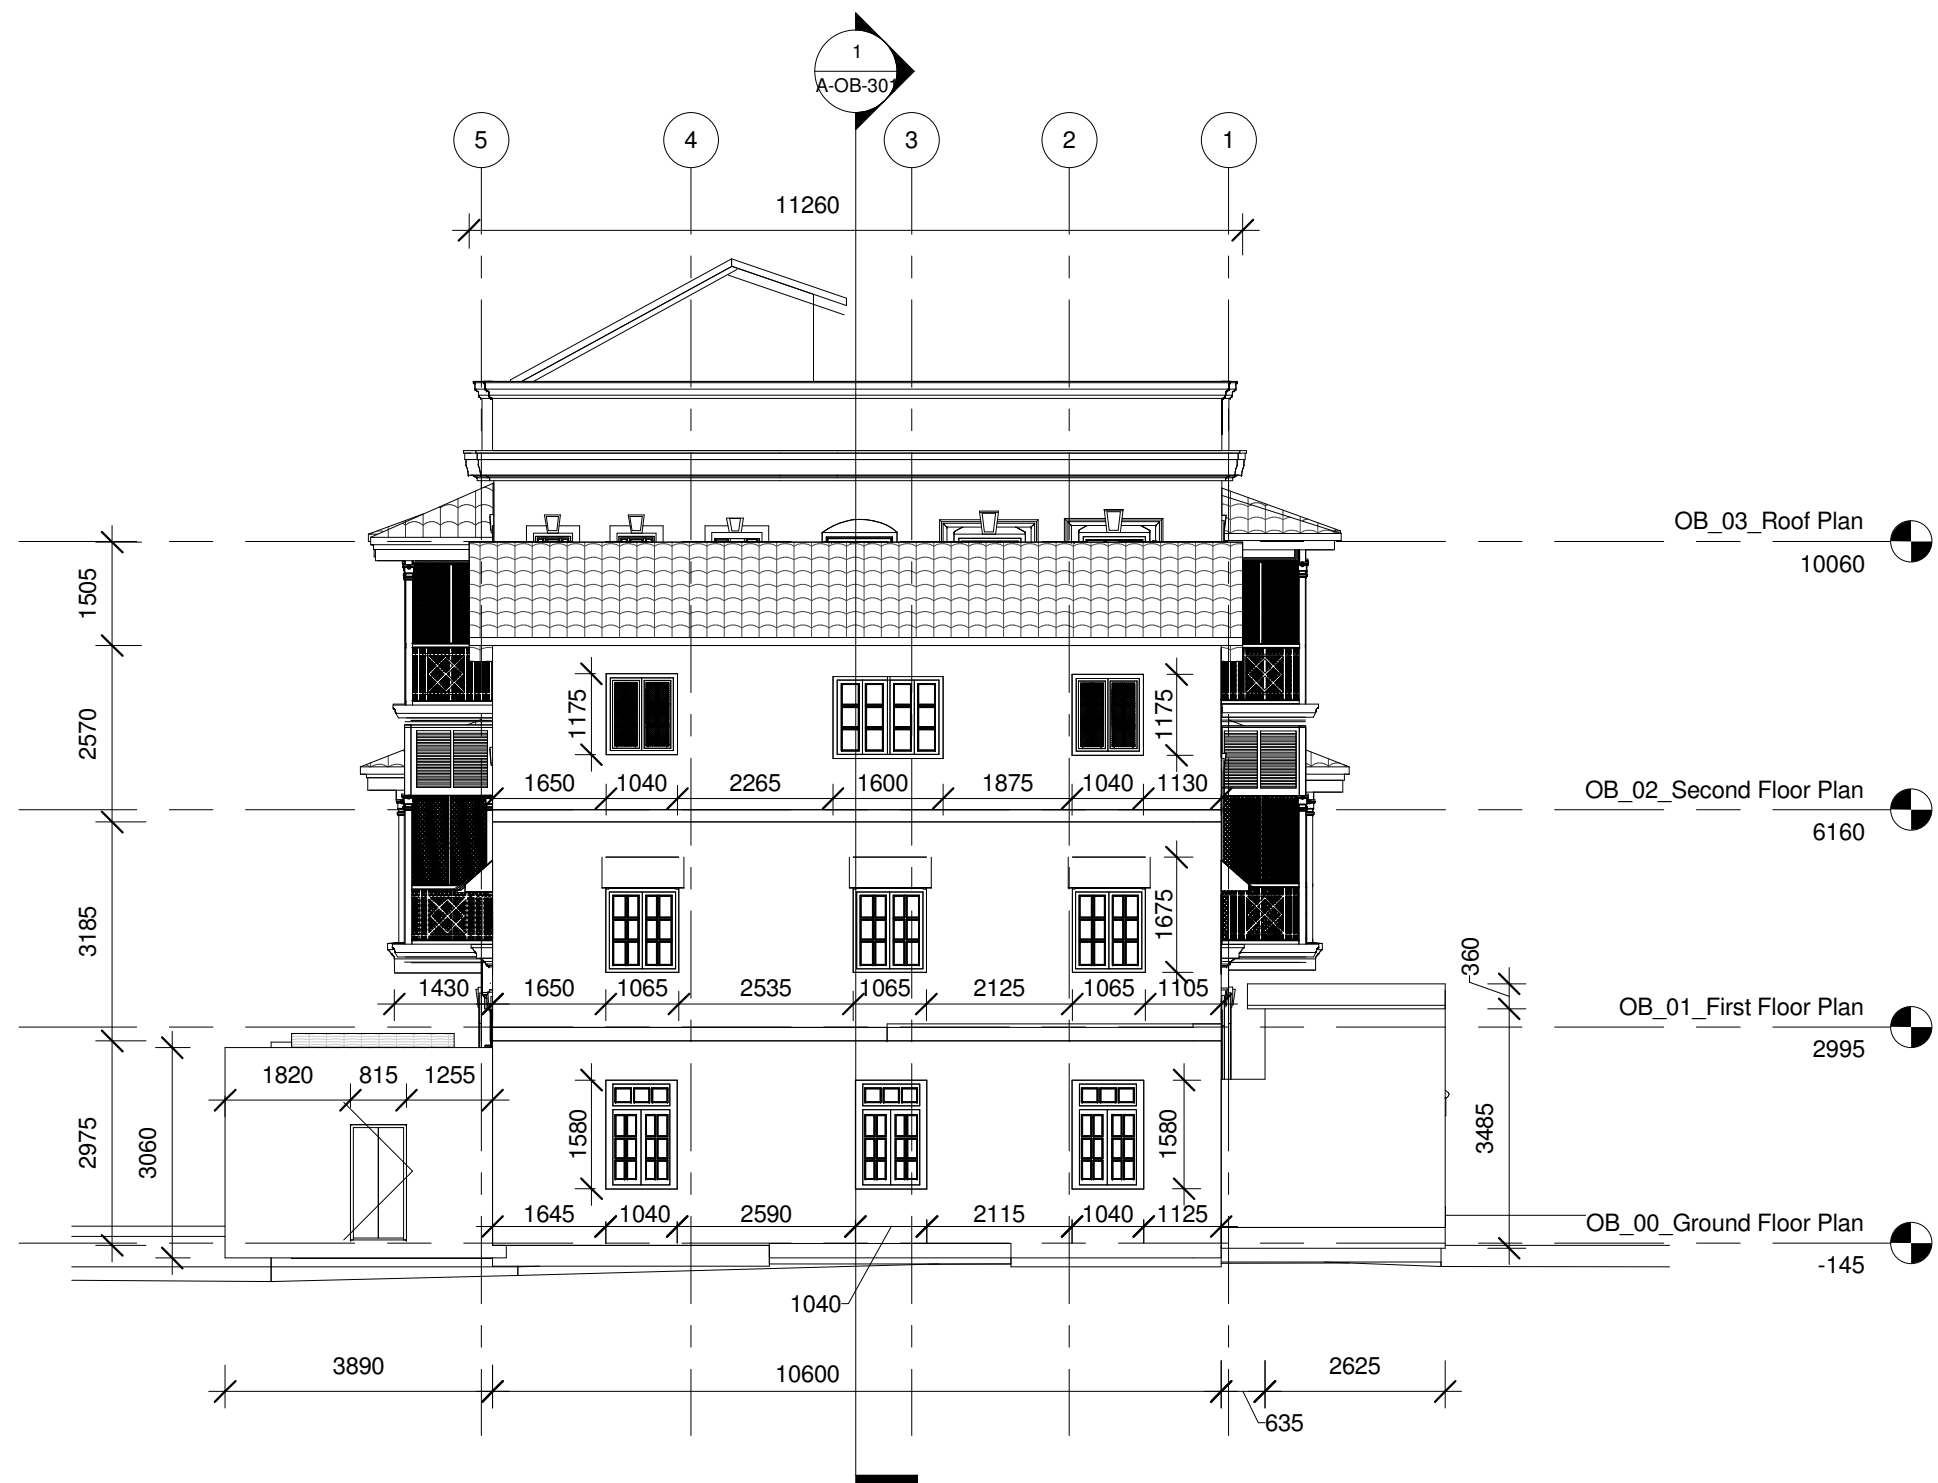

1 OB_East Elevation
1 : 100


0	First Issue	03 Oct 2019	
Rev.No	Purpose of Issue	Date	
R E V I S I O N			
TITLE:- Old Building - East Elevation			
PROJECT:- Gandhi Heritage Sites Mission, Ministry of Culture, Govt. of India			
SITE:- Mani Bhavan 19, Laburnum Rd, near Police Station, Babulnath, Gamdevi. Mumbai, Maharastra - 400007 INDIA			
SCALE:- 1 : 100		DRG.No	REV.
DATE:- 03-10-2019		A-OB-203	0
Size:- A3			
Executed By: Sabarmati Ashram Preservation and Memorial Trust, Ahmedabad 380027, Gujarat - INDIA			
Technical Implementation Agency: SHAYONA MANAGEMENT SERVICES PVT. LTD. 4th Floor, Om Shayona Arcade, Nr.Silver Oak College of Engg.&Tech Gota,Ahmedabad - 382181 Gujarat, INDIA. Phone : +91 9925204263 Email : info@shayonamanagement.com Web : www.shayonamanagement.com			

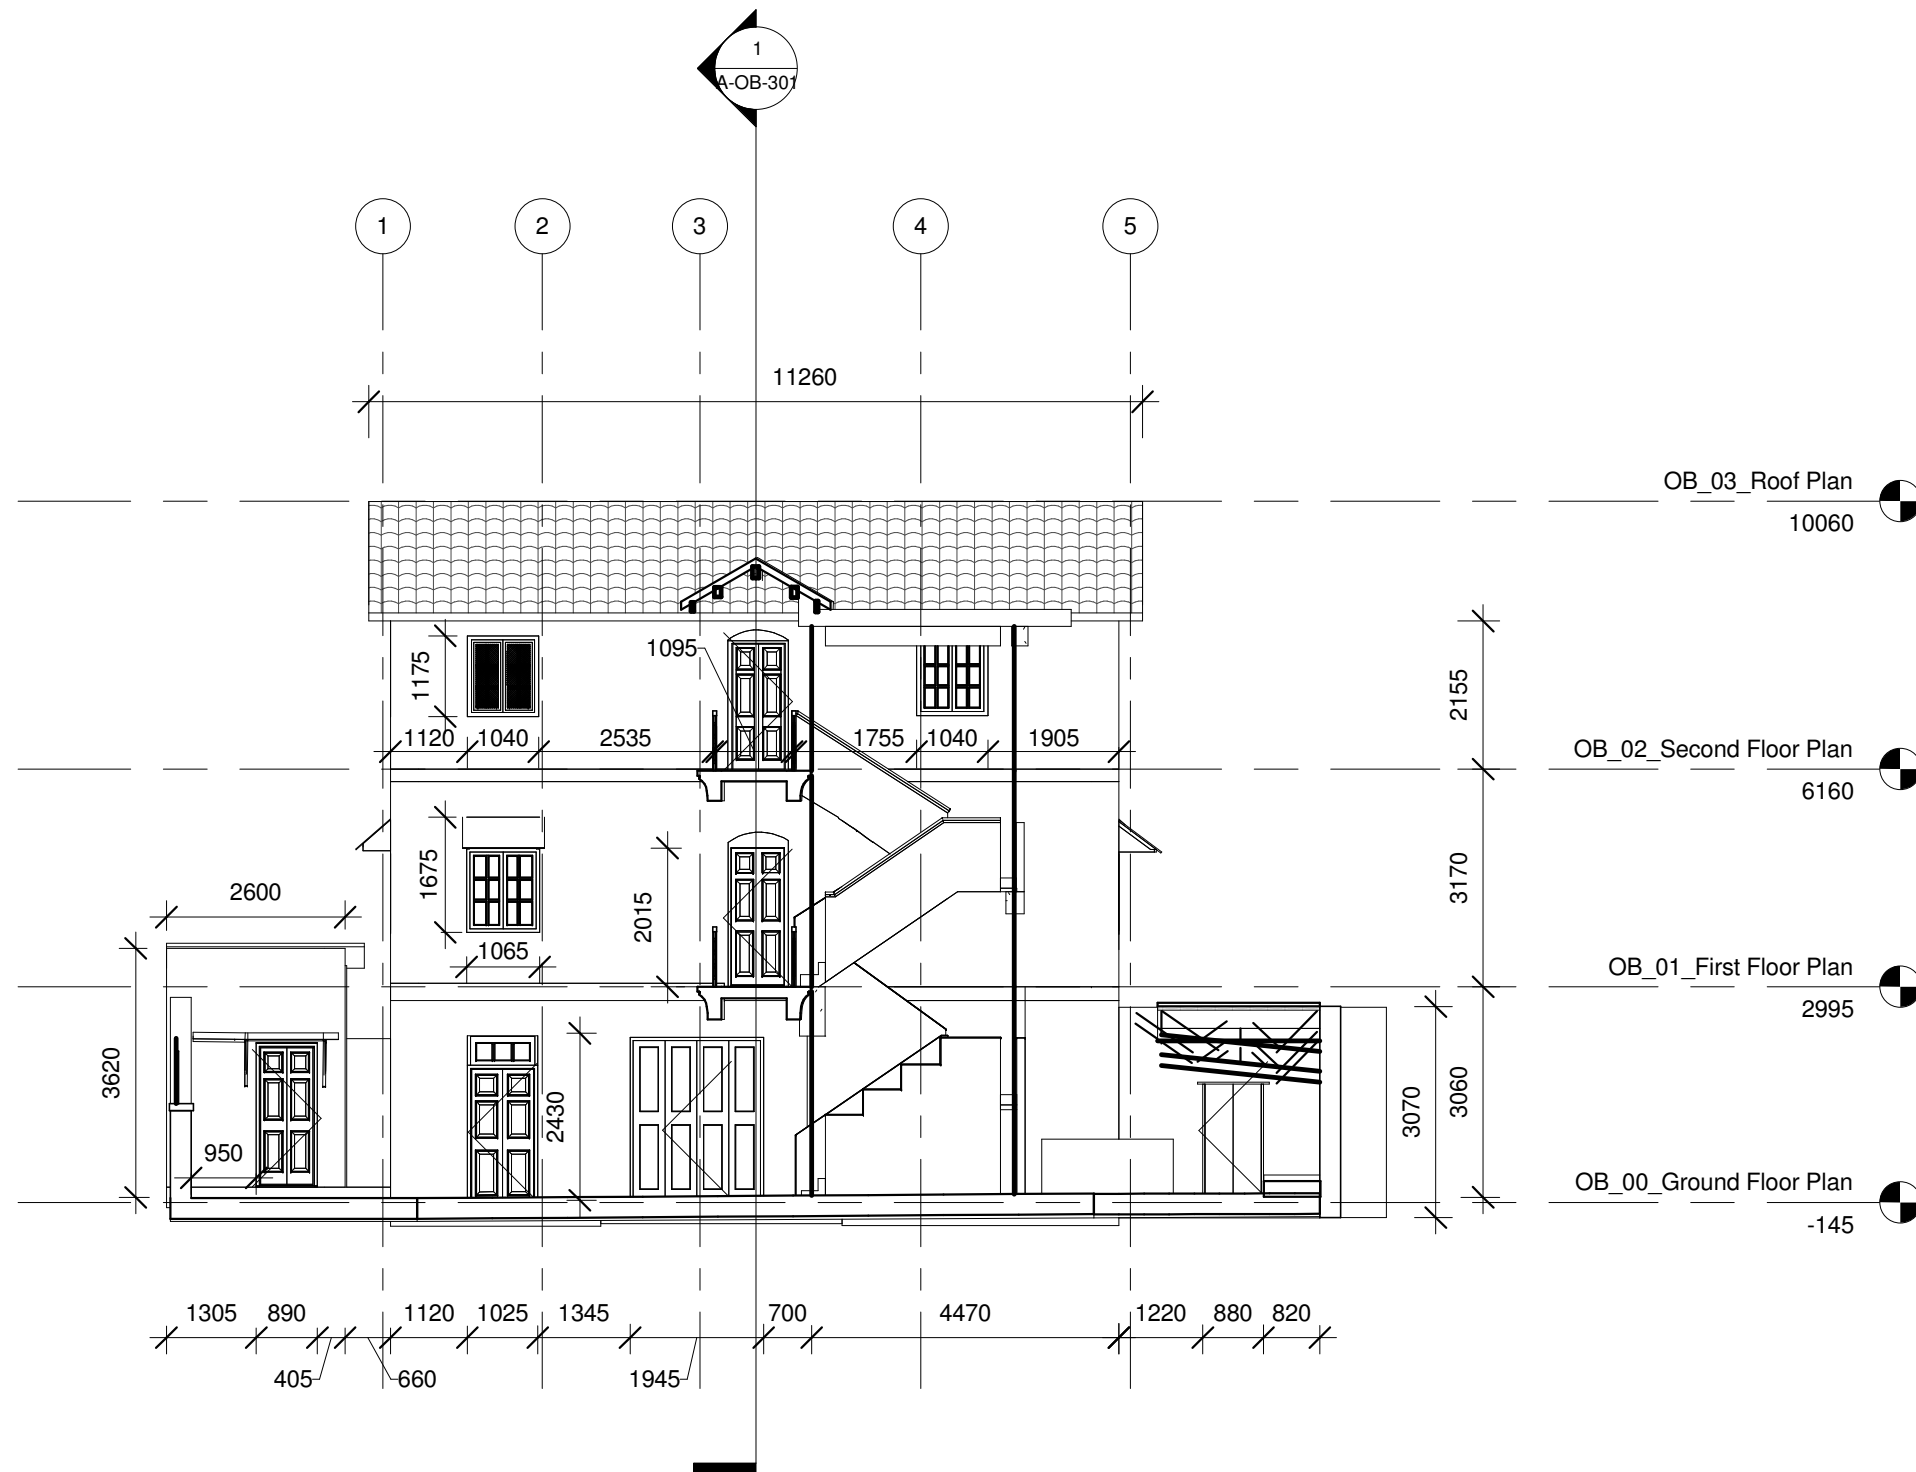


1 OB_West Elevation
1 : 100

0	First Issue	03 Oct 2019
Rev.No	Purpose of Issue	Date
R	E	V
I	S	I
O	N	
TITLE:- Old Building - West Elevation		
PROJECT:- Gandhi Heritage Sites Mission, Ministry of Culture, Govt. of India		
SITE:- Mani Bhavan 19, Laburnum Rd, near Police Station, Babulnath, Gamdevi. Mumbai, Maharastra - 400007 INDIA		
SCALE:- 1 : 100		DRG.No
DATE:- 03-10-2019		REV.
Size:- A3		0
A-OB-204		
0		
Executed By: Sabarmati Ashram Preservation and Memorial Trust, Ahmedabad 380027, Gujarat - INDIA		
Technical Implementation Agency: SHAYONA MANAGEMENT SERVICES PVT. LTD. 4th Floor, Om Shayona Arcade, Nr.Silver Oak College of Engg.&Tech Gota,Ahmedabad - 382181 Gujarat, INDIA. Phone : +91 9925204263 Email : info@shayonamanagement.com Web : www.shayonamanagement.com		

1 OB_Section A-A
1 : 100

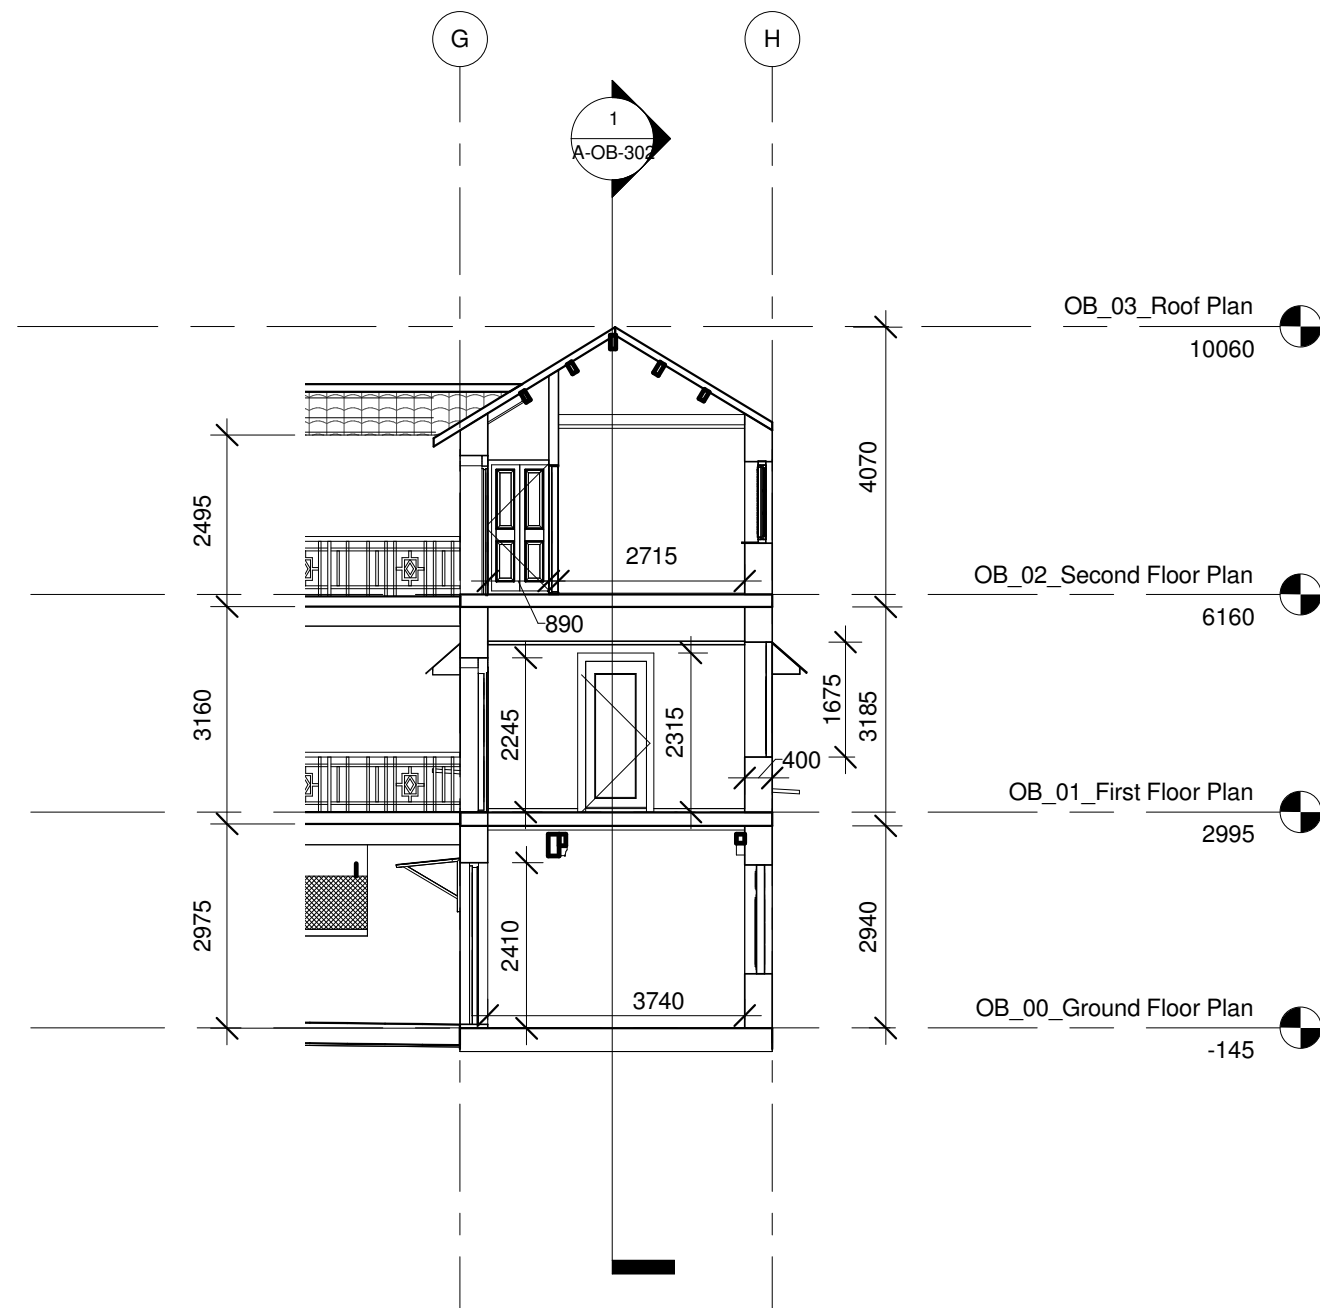

0	First Issue	03 Oct 2019					
Rev.No	Purpose of Issue	Date					
R	E	V	I	S	I	O	N
TITLE:- Old Building - Section A-A							
PROJECT:- Gandhi Heritage Sites Mission, Ministry of Culture, Govt. of India							
SITE:- Mani Bhavan 19, Laburnum Rd, near Police Station, Babulnath, Gamdevi. Mumbai, Maharastra - 400007 INDIA							
SCALE:- 1 : 100				DRG.No		REV.	
DATE:- 03-10-2019				A-OB-301		0	
Size:- A3							
Executed By: Sabarmati Ashram Preservation and Memorial Trust, Ahmedabad 380027, Gujarat - INDIA							
Technical Implementation Agency: SHAYONA MANAGEMENT SERVICES PVT. LTD. 4th Floor, Om Shayona Arcade, Nr.Silver Oak College of Engg.&Tech Gota,Ahmedabad - 382181 Gujarat, INDIA. Phone : +91 9925204263 Email : info@shayonamanagement.com Web : www.shayonamanagement.com							

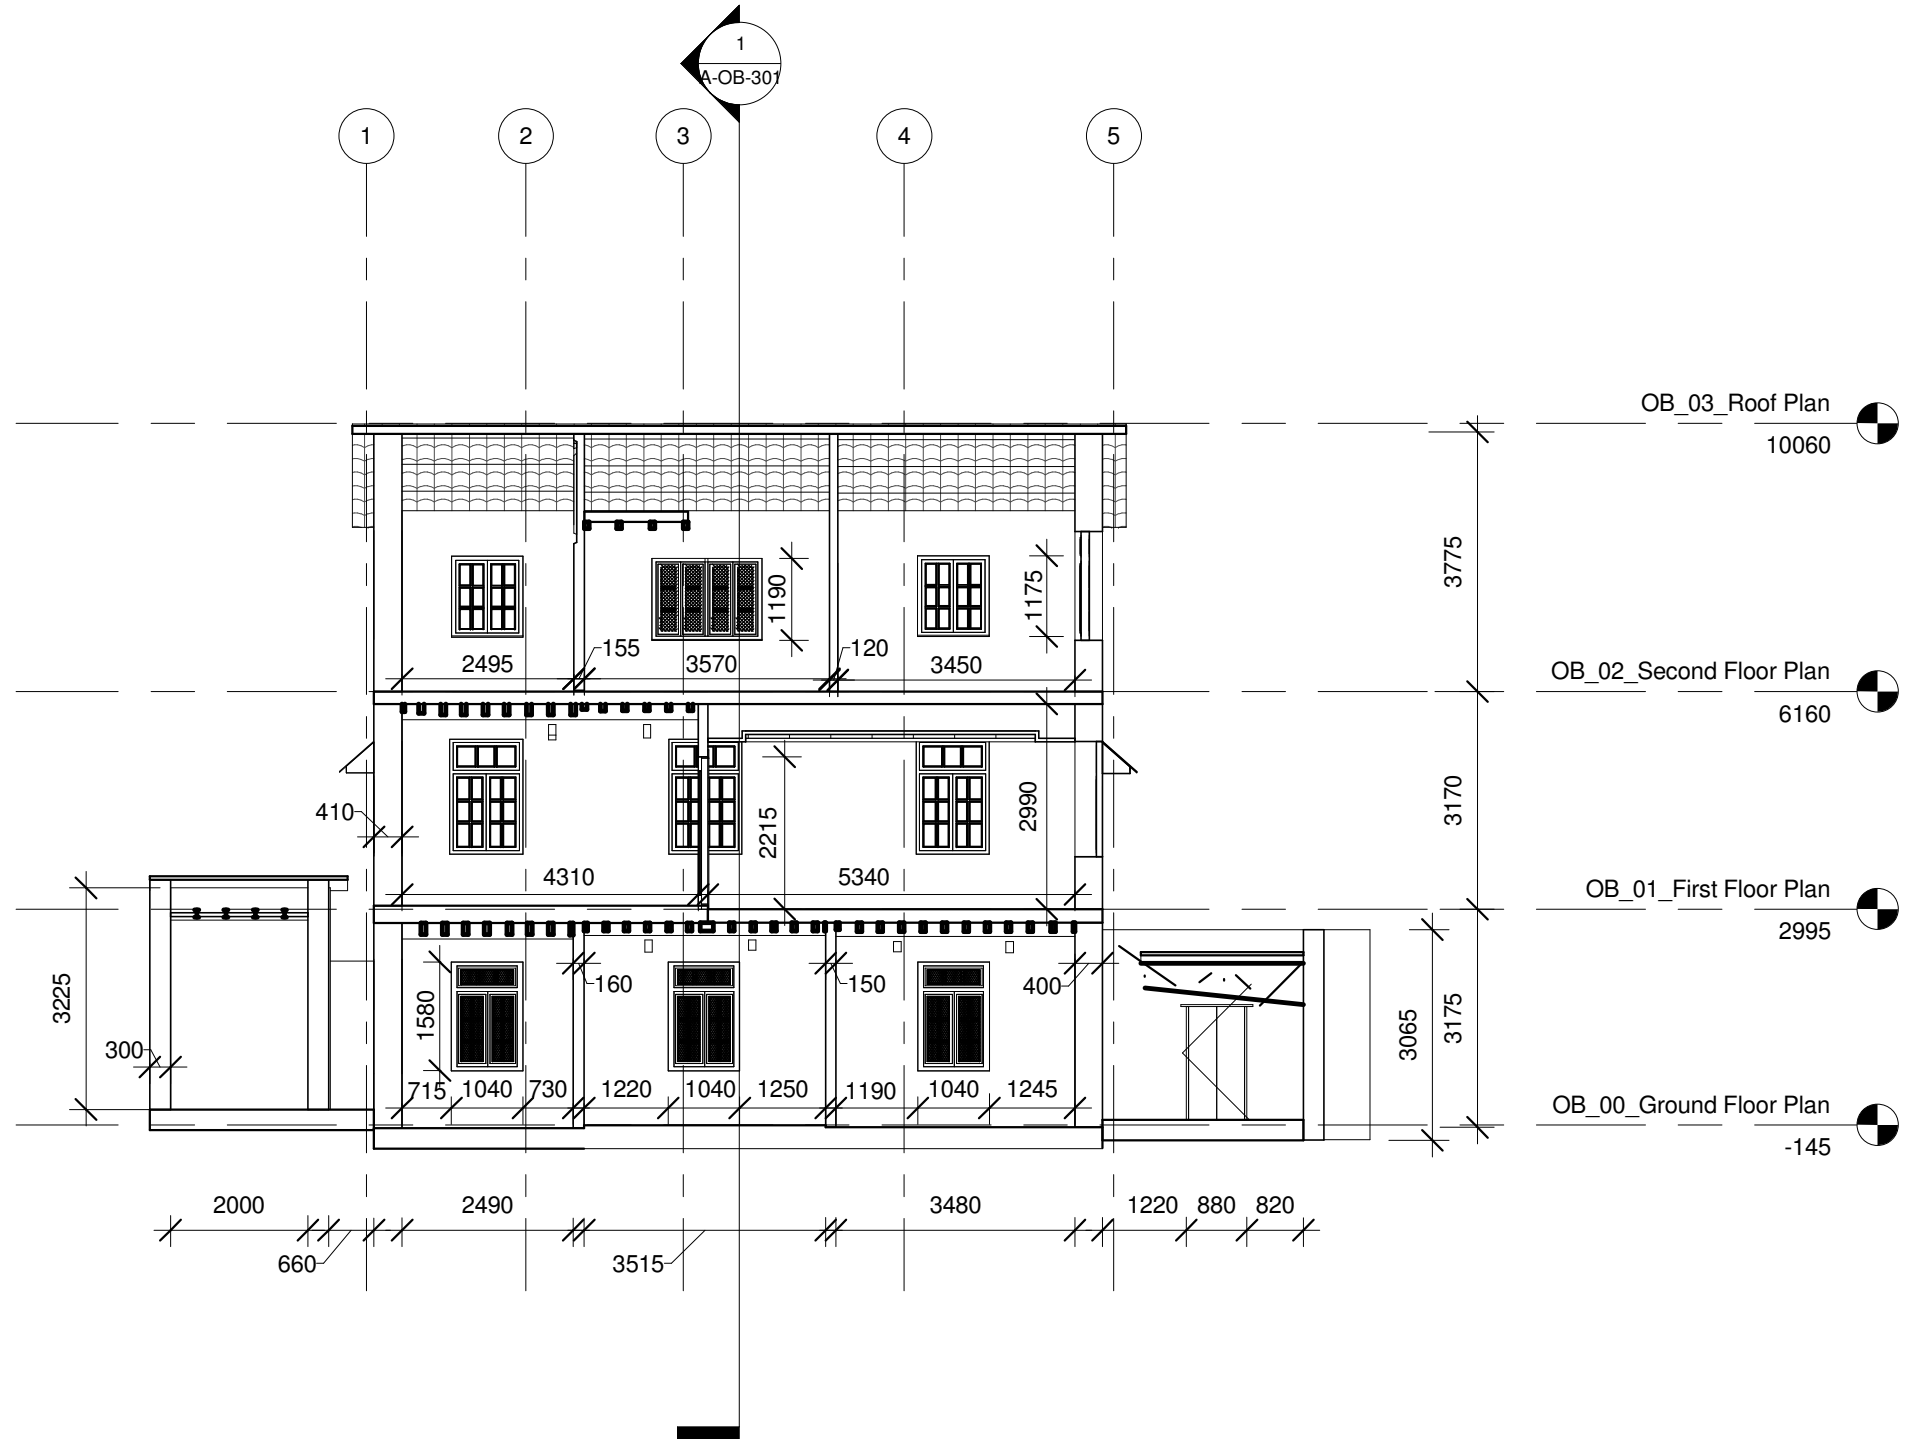

1 OB_Section B-B
1 : 100

0	First Issue	03 Oct 2019	
Rev.No	Purpose of Issue	Date	
R E V I S I O N			
TITLE:- Old Building - Section B-B			
PROJECT:- Gandhi Heritage Sites Mission, Ministry of Culture, Govt. of India			
SITE:- Mani Bhavan 19, Laburnum Rd, near Police Station, Babulnath, Gamdevi. Mumbai, Maharastra - 400007 INDIA			
SCALE:- 1 : 100		DRG.No	REV.
DATE:- 03-10-2019		A-OB-302	0
Size:- A3			
Executed By: Sabarmati Ashram Preservation and Memorial Trust, Ahmedabad 380027, Gujarat - INDIA			
Technical Implementation Agency: SHAYONA MANAGEMENT SERVICES PVT. LTD. 4th Floor, Om Shayona Arcade, Nr.Silver Oak College of Engg.&Tech Gota,Ahmedabad - 382181 Gujarat, INDIA. Phone : +91 9925204263 Email : info@shayonamanagement.com Web : www.shayonamanagement.com			



1 3D View 1

0	First Issue	03 Oct 2019
Rev.No	Purpose of Issue	Date
R	E	V
I	S	I
O	N	
TITLE:-		
3D View 1		
PROJECT:- Gandhi Heritage Sites Mission, Ministry of Culture, Govt. of India		
SITE:- Mani Bhavan 19, Laburnum Rd, near Police Station, Babulnath, Gamdevi, Mumbai, Maharastra - 400007 INDIA		
SCALE:-		DRG.No
DATE:- 03-10-2019		REV.
Size:- A3		0
Executed By:		
Sabarmati Ashram Preservation and Memorial Trust, Ahmedabad 380027, Gujarat - INDIA		
Technical Implementation Agency:		
SHAYONA MANAGEMENT SERVICES PVT. LTD.		
4th Floor, Om Shayona Arcade, Nr.Silver Oak College of Engg.& Tech Gota,Ahmedabad - 382181 Gujarat, INDIA.		
Phone : +91 9925204263		
Email : info@shayonamanagement.com		
Web : www.shayonamanagement.com		



1 3D View 2


0	First Issue	03 Oct 2019
Rev.No	Purpose of Issue	Date
R	E	V
I	S	I
O	N	
TITLE:- 3D View 2		
PROJECT:- Gandhi Heritage Sites Mission, Ministry of Culture, Govt. of India		
SITE:- Mani Bhavan 19, Laburnum Rd, near Police Station, Babulnath, Gamdevi. Mumbai, Maharastra - 400007 INDIA		
SCALE:-		DRG.No
DATE:- 03-10-2019		REV.
Size:- A3		0
Executed By: Sabarmati Ashram Preservation and Memorial Trust, Ahmedabad 380027, Gujarat - INDIA		
Technical Implementation Agency: SHAYONA MANAGEMENT SERVICES PVT. LTD. 4th Floor, Om Shayona Arcade, Nr.Silver Oak College of Engg.&Tech Gota,Ahmedabad - 382181 Gujarat, INDIA. Phone : +91 9925204263 Email : info@shayonamanagement.com Web : www.shayonamanagement.com		



VIEW 1



VIEW 2

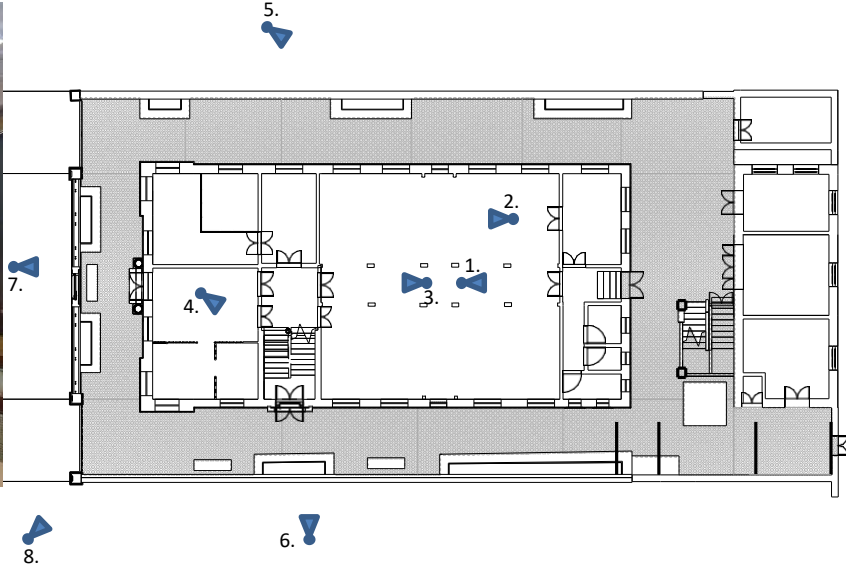

VIEW 3



VIEW 4



VIEW 5



VIEW 6



VIEW 7



VIEW 8

0	First Issue	03 Oct 2019	
Rev.No	Purpose of Issue	Date	
R E V I S I O N			
TITLE:- PHOTO DOCUMENTATION			
PROJECT:- Gandhi Heritage Sites Mission, Ministry of Culture, Govt. of India			
SITE:- Mani Bhavan 19, Laburnum Rd, near Police Station, Babulnath, Gamdevi. Mumbai, Maharastra - 400007 INDIA			
SCALE:-1 : 300		DRG.No	REV.
DATE:- 03-10-2019		A-ZZ-403	0
Size:- A3			
Executed By: Sabarmati Ashram Preservation and Memorial Trust, Ahmedabad 380027, Gujarat - INDIA			
Technical Implementation Agency: SHAYONA MANAGEMENT SERVICES PVT. LTD. 4th Floor, Om Shayona Arcade, Nr.Silver Oak College of Engg.&Tech Gota,Ahmedabad - 382181 Gujarat, INDIA. Phone : +91 9925204263 Email : info@shayonamanagement.com Web : www.shayonamanagement.com			