


LEGEND


- 1. HOSTEL ROOM
- 2. 2450 WIDE CORRIDOR
- 3. TOILET BLOCK
- 4. OPEN OTLA
- 5. OFFICE SPACE
- 6. CLASSROOM
- 7. BIBLE ROOM

CORE SITE	DRAWING				LEGENDS		SCALE 1:200 NORTH		PROJECT	
	SHEET. TITLE:	GROUND FLOOR PLAN			STRUCTURES ON SITE	PLINTHS				GANDHI HERITAGE SITES MISSION
DIVERSOR GUIDATI UTUMA DELIVERA	DRG. NO. :	GHSM/AMD/BRGV/01/02	DRAWN BY:	AKANSHA	GATE	GROUND FLOOR PLAN				SABARMATI ASHRAM PRESERVATION AND MEMORIAL TRUST
BIBLE ROOM, GUJRAT VIDYAPEETH	DATE:	18-06-2015	CHECKED BY:	SOURAV	PATH	GROUND FLOOR PLAN	0.5 0 2 15	25 M		TIVE WEIGHT TRUST

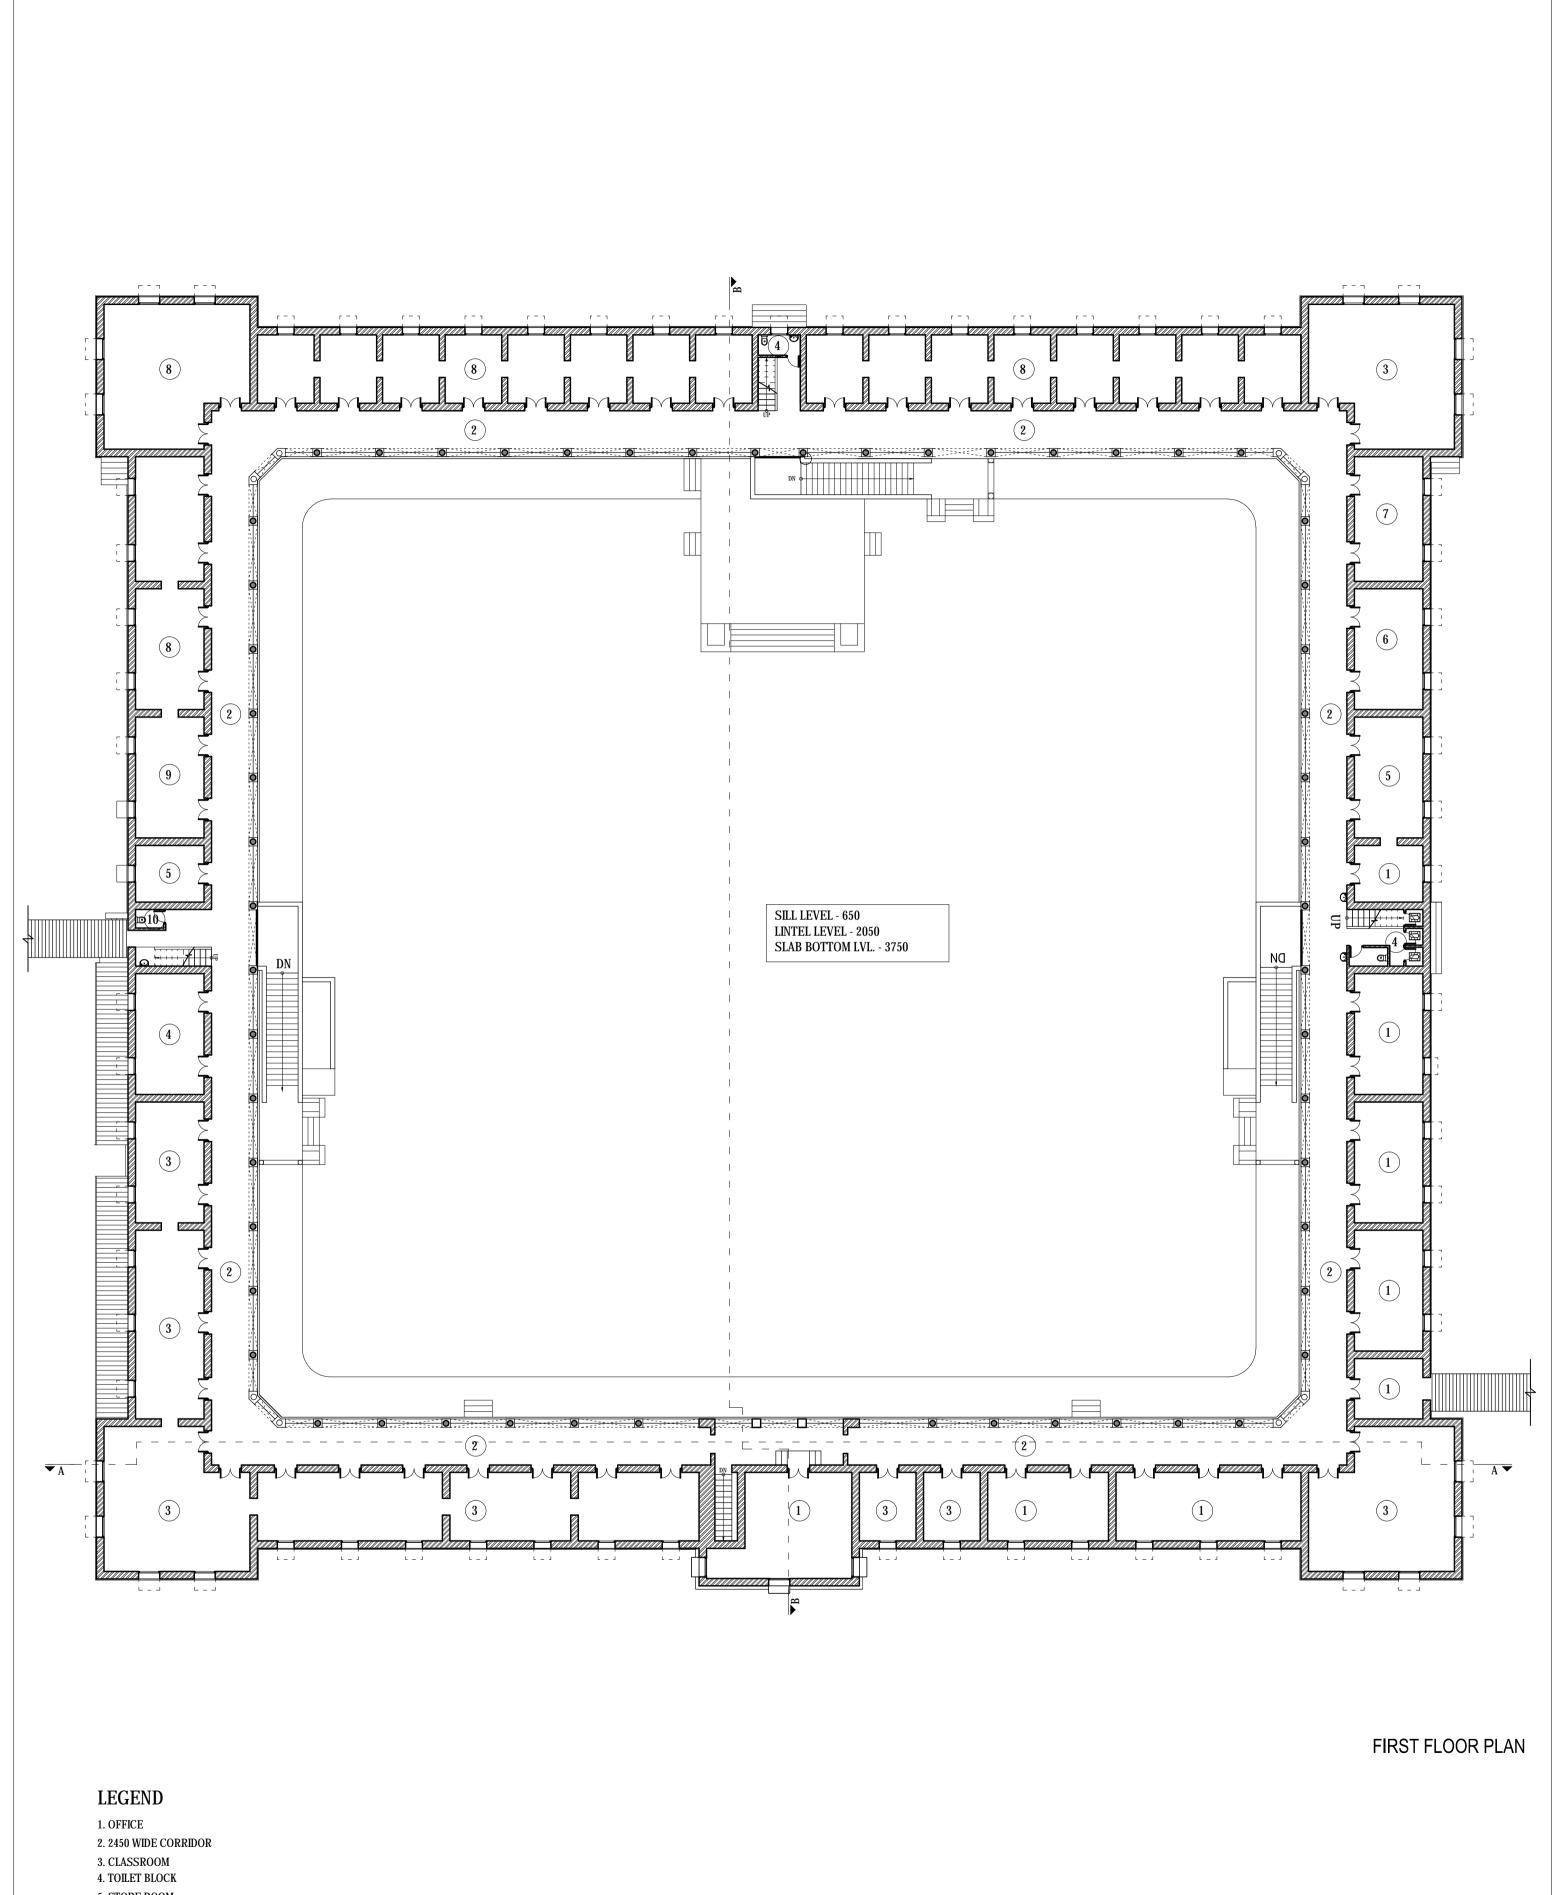

- 5. STORE ROOM
- 6. LIBRARY
- 7. COMPUTER ROOM 8. SCIENCE MUSEUM
- 9. STAFF ROOM


CORE SITE	DRAWING				LEGENDS		SCALE	1:200 NOR	RTH	PROJECT
	SHEET. TITLE:	FIRST FLOOR PLAN			STRUCTURES ON SITE	PLINTHS				GANDHI HERITAGE SITES MISSION
	DRG. NO. :	GHSM/AMD/BRGV/01/03	DRAWN BY:	AKANSHA	GATE	GROUND FLOOR PLAN		- (SABARMATI ASHRAM PRESERVATION AND MEMORIAL TRUST
BIBLE ROOM, GUJRAT VIDYAPEETH	DATE :	18-06-2015	CHECKED BY:	SOURAV	PATH	GROUND FLOOR PLAN	0.5 0 2 15	5 M		AND MEMORIAL TRUST

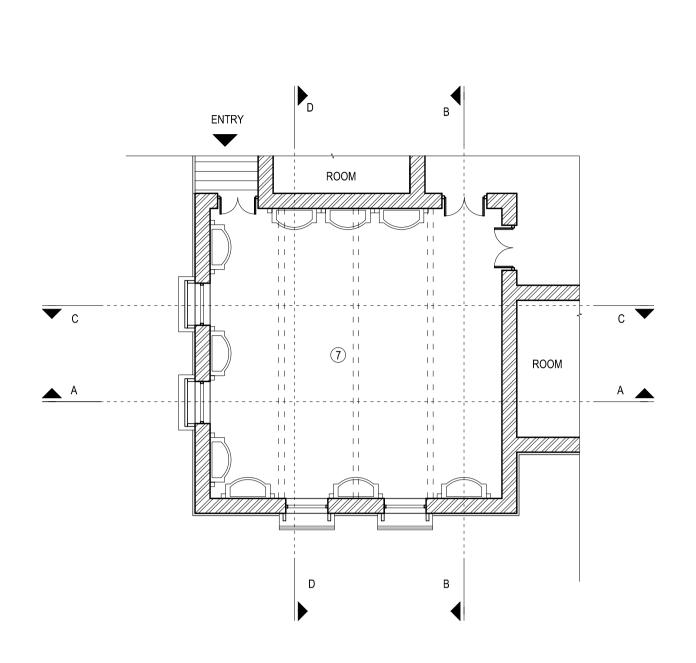



BIBLE KHAND


BIBLE KHAND PLAN

KEY PLAN SCALE 1:500

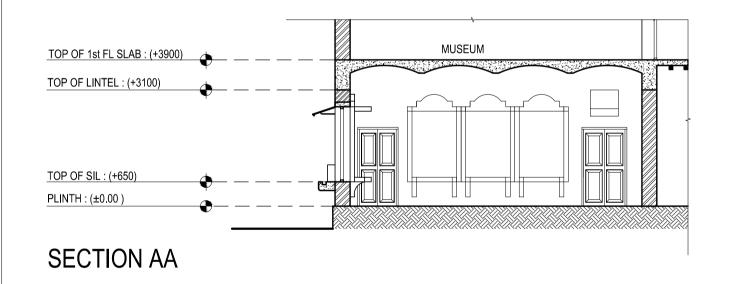

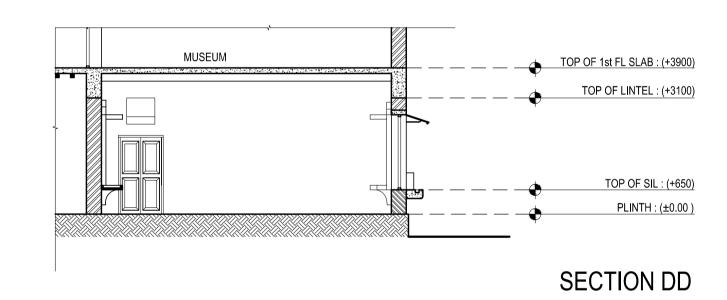


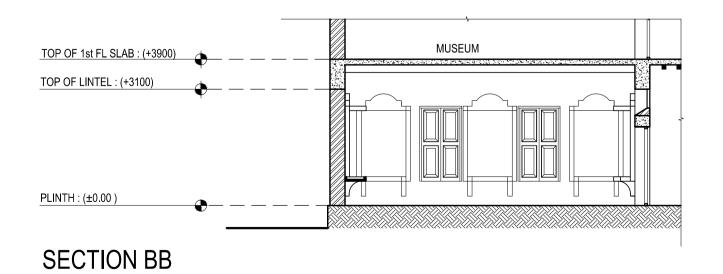


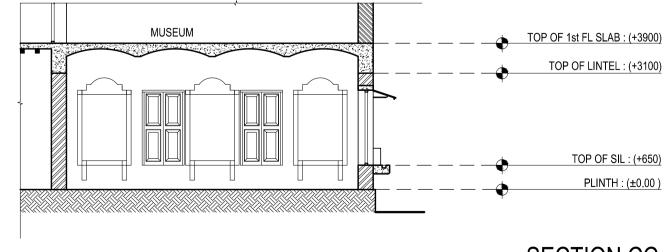

SECTION CC

CORE SITE	DRAWING	DRAWING			LEGENDS		SCALE 1:100		NORTH PROJECT		
	SHEET. TITLE :	PART PLAN AND SECTIONS			STRUCTURES ON SITE	PLINTHS				GANDHI HERITAGE SITES MISSION	
	DRG. NO. :	GHSM/AMD/BRGV/01/06	DRAWN BY:	RONY	GATE	GROUND FLOOR PLAN				SABARMATI ASHRAM PRESERVATION AND MEMORIAL TRUST	
BIBLE ROOM, GUJRAT VIDYAPEETH	DATE:	11-07-2015	CHECKED BY:	SOURAV	PATH	GROUND FLOOR PLAN	0.5 0 1 3	5 M		AND MEMORIAL INUST	

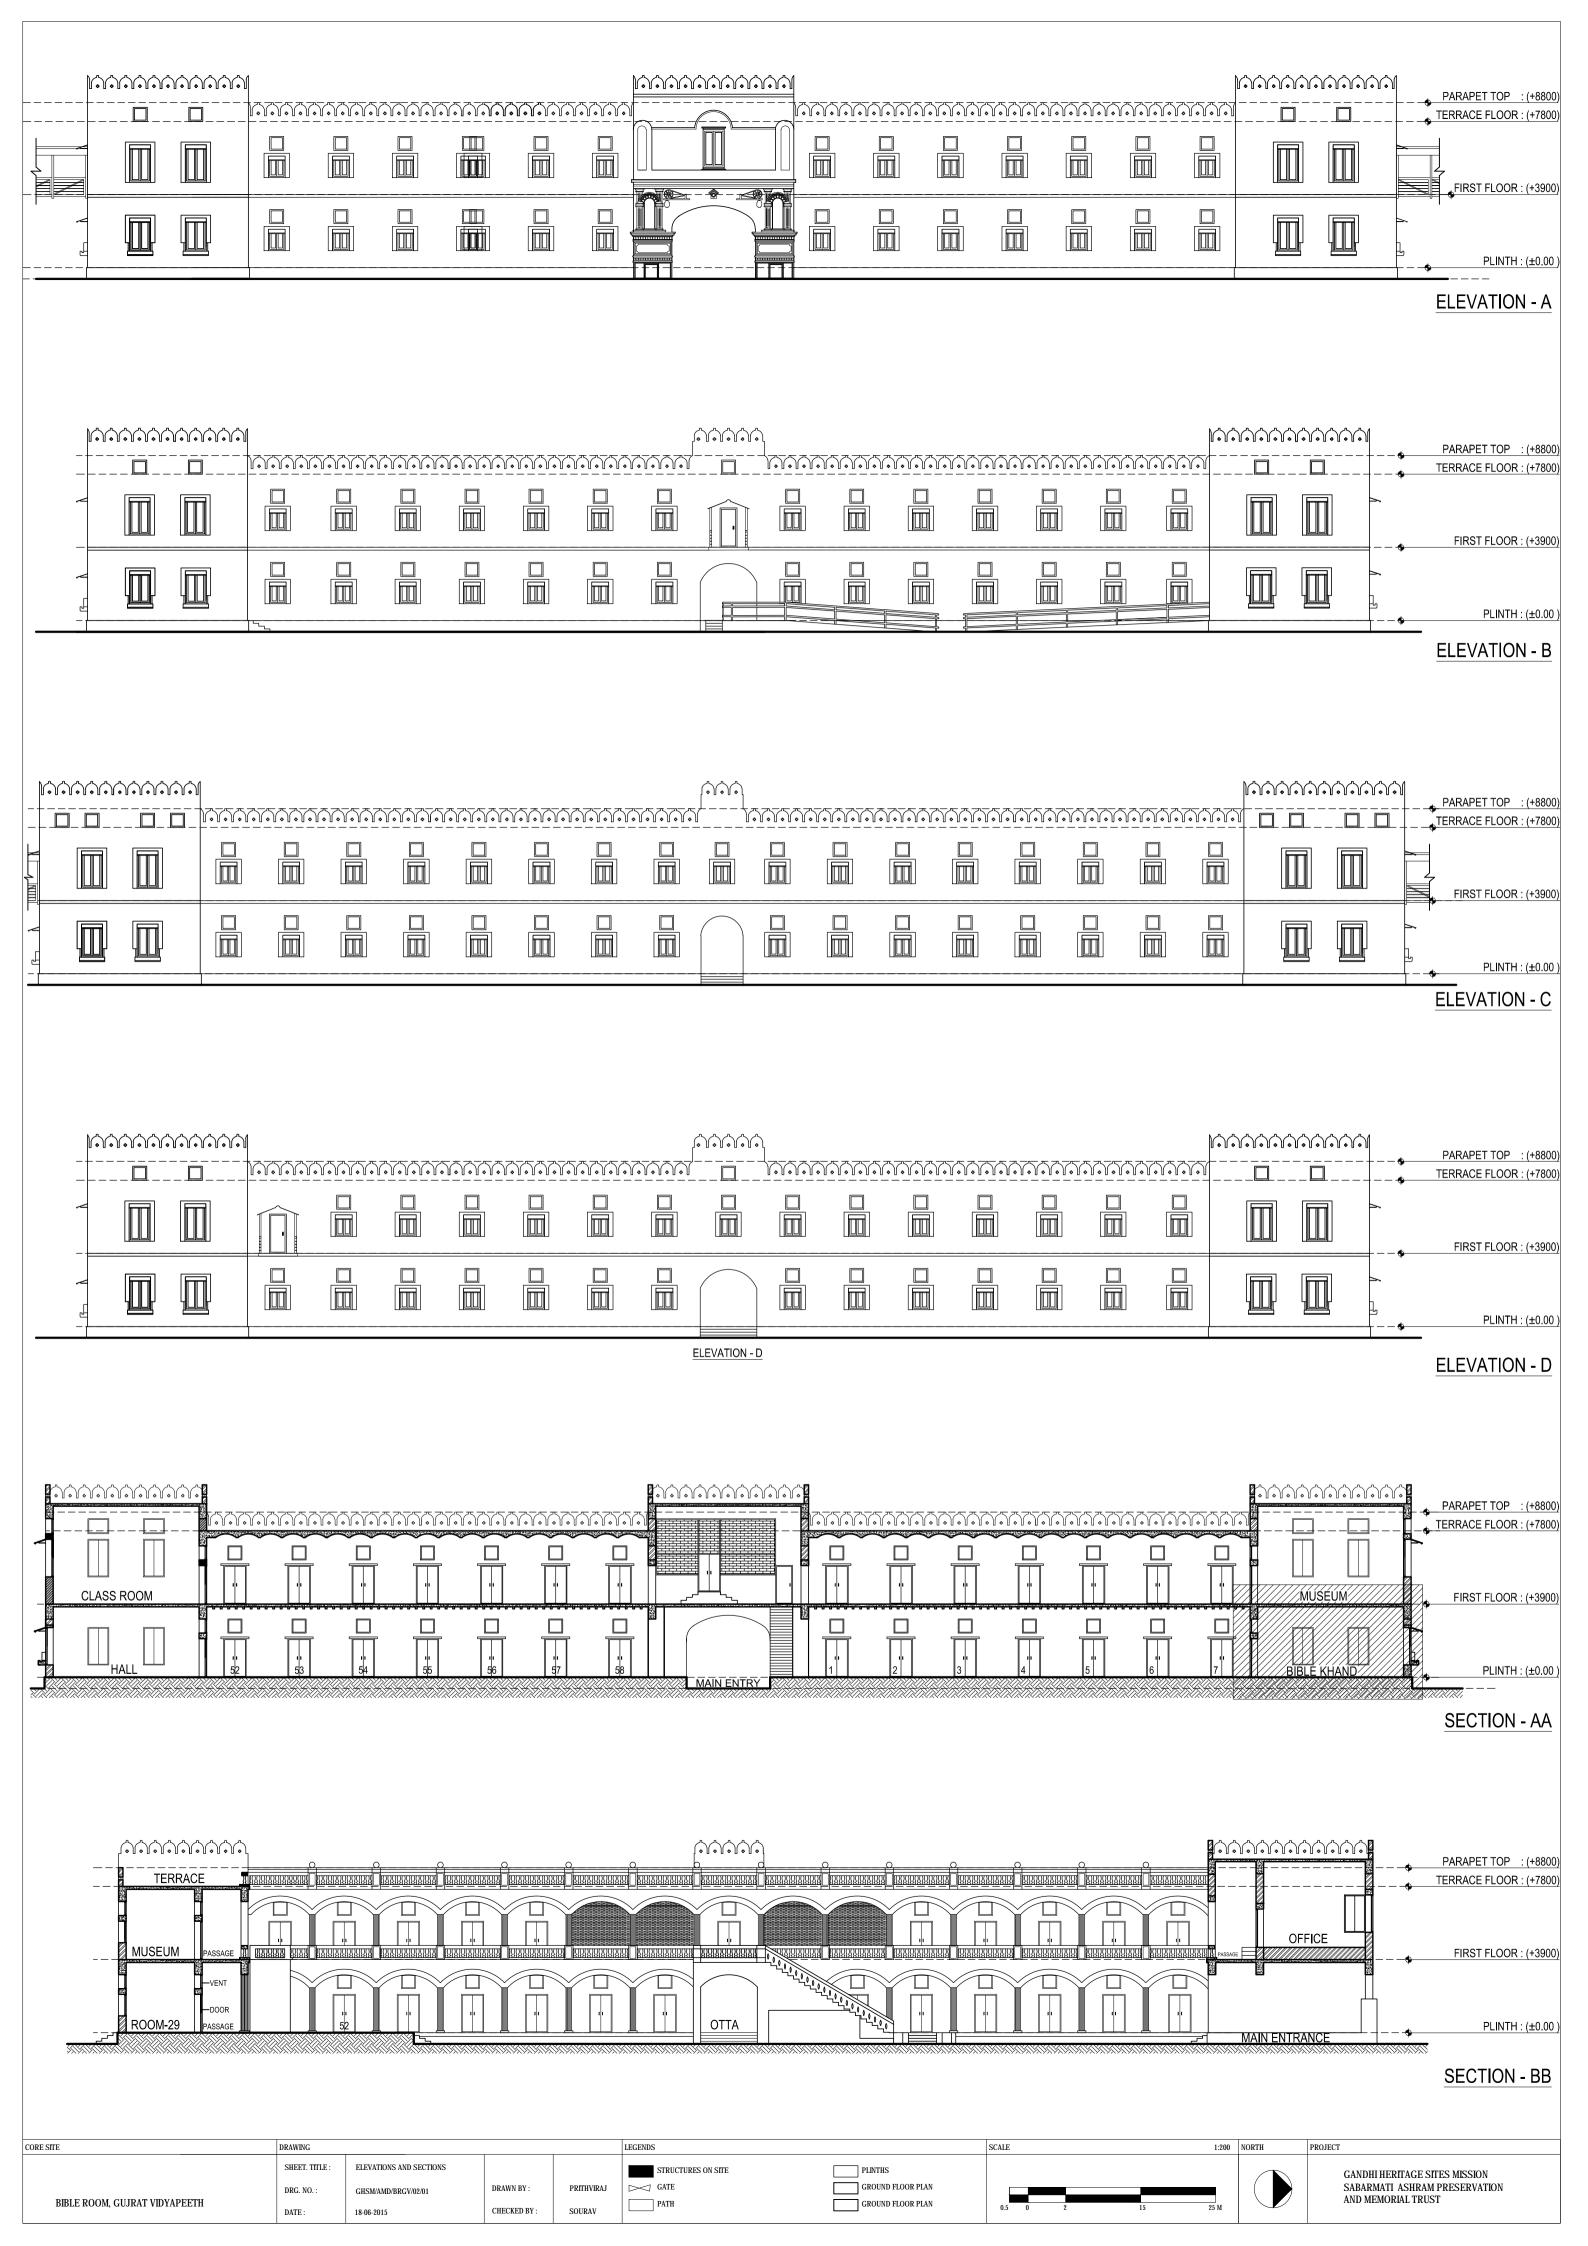

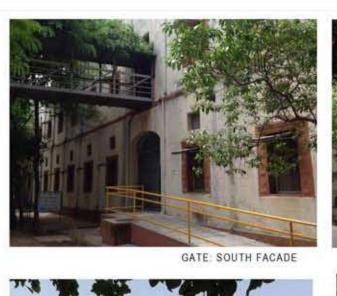



EAST FACADE DETAIL



MAIN GATE: EAST FACADE



SOUTH WEST BASTION



MAIN GATE: EAST FACADE



SOUTHERN FACADE




GATE: SOUTHERN FACADE



BRIDGE: SOUTHERN FACADE

CORE SITE LEGENDS DRAWING 1:5000 NORTH PROJECT SHEET, TITLE : PHOTOGRAHIC DOCUMENTATION PLINTHS GANDHI HERITAGE SITES MISSION SABARMATI ASHRAM PRESERVATION AND MEMORIAL TRUST STRUCTURES ON SITE EXTERIOR GATE GROUND FLOOR PLAN GHSM/AMD/BRGV/01/00 GROUND FLOOR PLAN BIBLE ROOM, GUJRAT VIDYAPITH, AHMEDABAD 02-07-2015 CHECKED BY

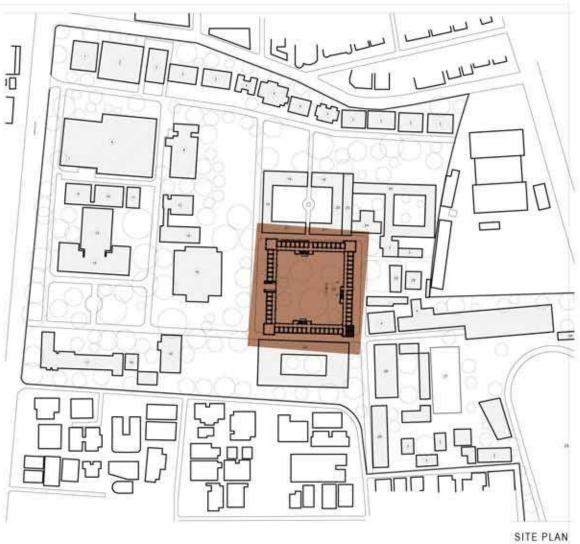





ROOF BALUSTRADEDETAILS



STAIR DETAIL ROOF



STAIRCASE



OPEN OTLA




MAIN ENTERANCE




GROUND FLOOR CORRIDOR



COLUMN/DOOR DETAIL

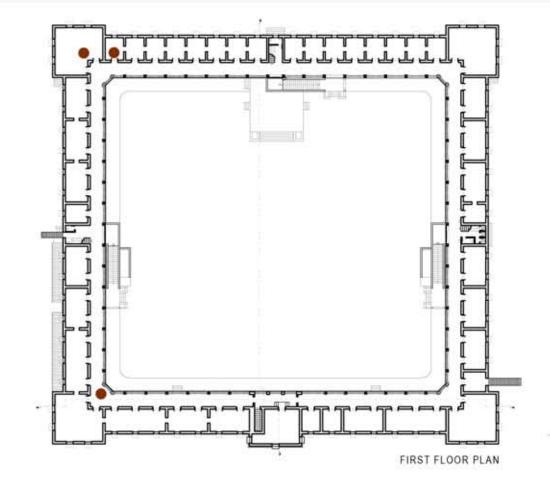

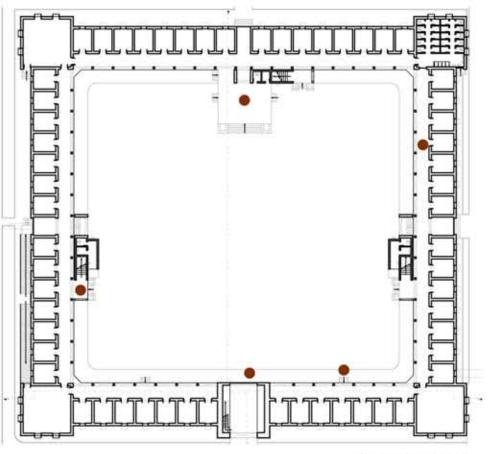

GROUND FLOOR PLAN

CORE SITE DRAWING 1:750 NORTH PHOTOGRAHIC DOCUMENTATION SHEET, TITLE : PLINTHS STRUCTURES ON SITE GANDHI HERITAGE SITES MISSION INTERIOR DRAWN BY GATE GROUND FLOOR PLAN SABARMATI ASHRAM PRESERVATION GHSM/AMD/BRGV/01/00 AND MEMORIAL TRUST PATH GROUND FLOOR PLAN CHECKED BY: SOURAV BIBLE ROOM, GUJRAT VIDYAPITH, AHMEDABAD DATE: 02-07-2015








ROOF DETAIL

WINDOW DETAIL

WALL DETAIL





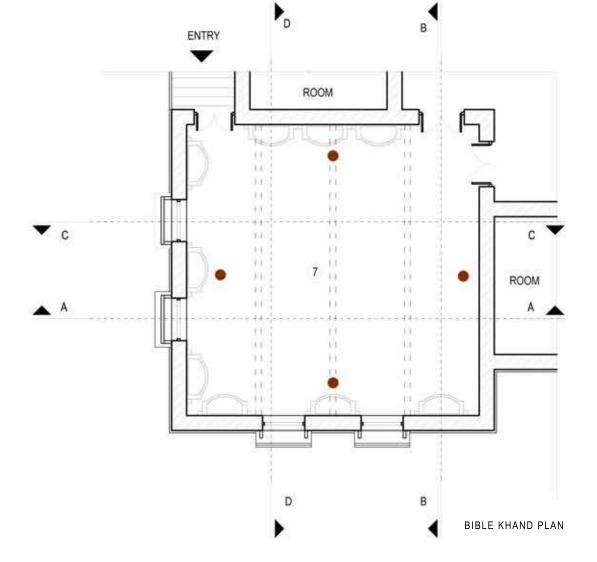

EXTERIOR ENTRANCE

WALL WITH THE DOORS

RIGHT WALL

LEFT WALL

ORE SITE	DRAWING				LEGENDS		SCALE	1:100 NORTH	PROJECT
	SHEET, TITLE	BIBLE ROOM PLAN			STRUCTURES ON SITE	PLINTHS			GANDHI HERITAGE SITES MISSION
	DRG. NO.	GHSM/AMD/BRGV/01/06	DRAWN BY	RONY	GATE	GROUND FLOOR PLAN			SABARMATI ASHRAM PRESERVATION AND MEMORIAL TRUST
BIBLE ROOM, GUJRAT VIDYAPEETH	DATE	11-07-2015	CHECKED BY	SOURAV	PATH	GROUND FLOOR PLAN	0.5 0 1	3 9M	AND MEMORIAL TROS